

Name Mary E. Boyce  
 Address <sup>30</sup>~~48~~ Charles St.

Service No. 152

Location

Kind of Pipe

Size

Size of Main

~~Repair~~ ~~Renewal~~ New Service

Location

Date	Material	Amount	Total	Date	Amount
P. 6-16-31 for 41.58	25' 6" Sewer Pipe @ .25	6 25			
	10' 4" Iron " @ .50	5 00			
	Sulphur & Jute	1 00			
	Trucking	<u>75</u>	13 00	May 11 1931 - Cash	30
				Oct. 7 1931 - Cash	11 58
15/31	43 Hrs. Labor @ .55	23 65			
	2 " " @ .60	<u>1 20</u>	24 85		
	15% Overhead		<u>3 73</u>		
			41 58		
	Labor				

H. G. Press, Inc., Lexington

Will pay 30.00 +  
" " balance in Sept. 1931.

TOWN OF LEXINGTON—BOARD OF PUBLIC WORKS

SEWER DIVISION

DATE May 11, 1931

NO. \_\_\_\_\_


The undersigned applies for the construction of a particular sewer connecting No. 46 Charles St. Street and hereby agrees to comply with the Rules and Regulations governing the construction and use of Particular Sewers, as now or at any future time established by the Board of Selectmen.

Am't. of Estimate \$ \_\_\_\_\_

Am't. Paid \$ 30 — 5/11/31

Wm & Boyle Owner

Sketch of Service Here

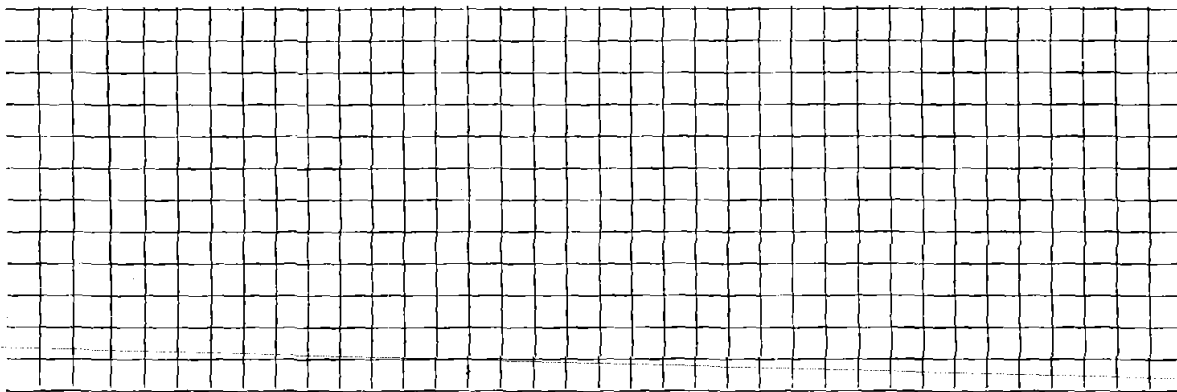

Connection made in \_\_\_\_\_ Street.

Work completed \_\_\_\_\_ 19

Remarks: