

Name Charles McGillivary

Service No. ~~35~~⁴ 153

Address 33 Charles Street

Location Same

Kind of Pipe Size Size of Main

~~Repair - Renewal~~ - New Service

Location

Date	Material	Amount	Total	Date	Amount
11/22/35	51 hrs. labor @ 55¢	28 05		Nov. 23 1935 June	50 00
Com. 8 56.76 12-30-35 to Renewal	22 " " @ 60¢	13 20			
			41 25		
	10% Ovhd. on labor		4 13		
	33' 6" Sewer Pipe @ 16¢	5 28		8/18/88	24' 6" PVC
	Sulphur & Jute	1 60			1 6" Clay - PVC Fernco
	Trucking	1 00			
	Compressor 1 hrs.	3 50			
			11 38		
			56 76		
			6 76		
			50 00		
				Billed 12-31-35	
	Labor			8/4/88	SIEMISE Roots in pipe down.
				8-21-75	Paper

Hadley Press, Inc., Lexington

June 9th, 1936 - Abated

TOWN OF LEXINGTON—BOARD OF PUBLIC WORKS

SEWER DIVISION

DATE Oct. 26. 1935

NO. 33 Charles St.


The undersigned applies for the construction of a particular sewer connecting No. 33 Charles St. Street and hereby agrees to comply with the Rules and Regulations governing the construction and use of Particular Sewers, as now or at any future time established by the Board of Selectmen.

Am't. of Estimate \$ 50.00

Am't. Paid \$ _____

Charles M. Gallivan Owner

Owner to dig own trench.

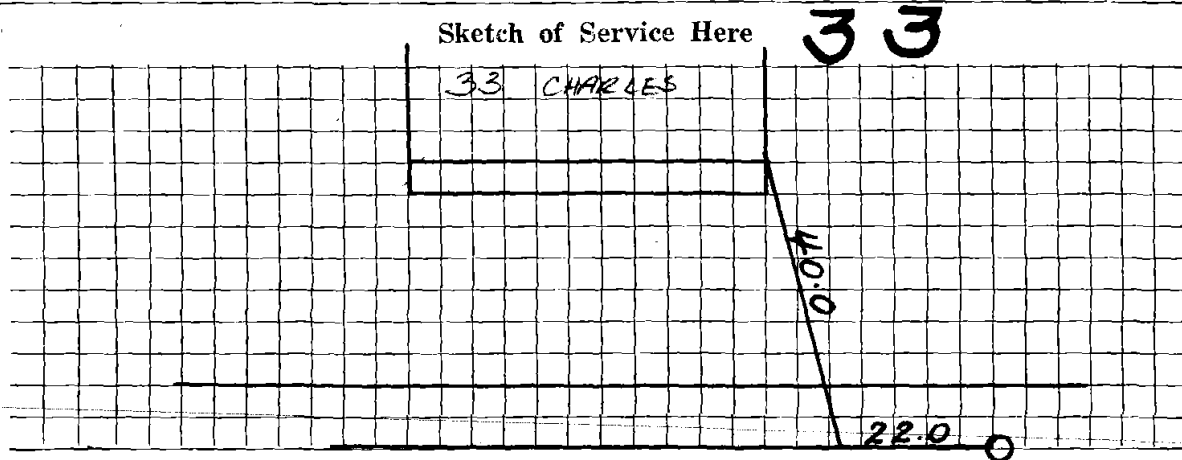

Connection made in _____ Street.

Work completed _____ 19

Remarks: