


DATE 10/12/95.

TOWN OF LEXINGTON — BOARD OF PUBLIC WORKS
SEWER DIVISION

Sketch of Service Here **4**

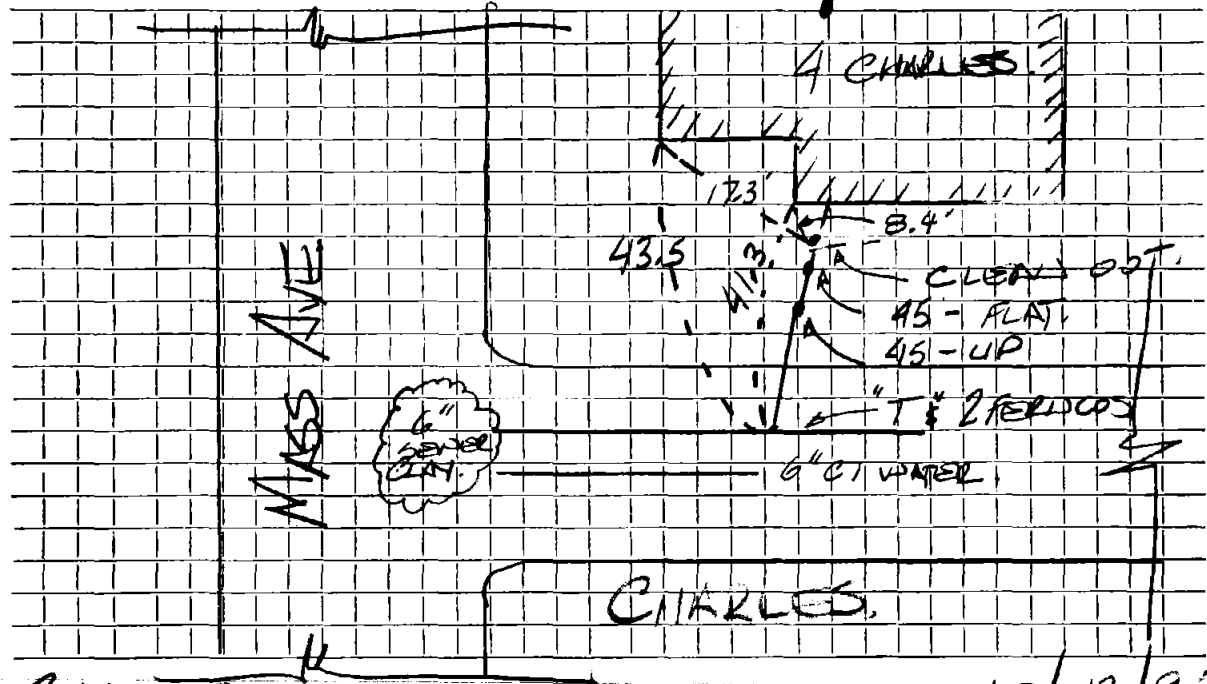

Connection made in CHARLES Street. Work completed 10/12/95

Remarks: Mr. GAGNON - CONTRACTOR
T.F.H. - INSPECTOR