

Name Mr. Joseph Sousa
 Address ~~20~~⁶ Charles St.

Service No. 19 172

Location

Kind of Pipe

Size

Size of Main

~~Repair - Renewal~~ - New Service

Location

Date	Material	Amount	Total	Date	Amount
<i>Comm. 48.71</i> 8-16-32	40' 6" Sewer Pipe @.15	\$6 00		1932 June 27	Cash 60 00
	2 6" 1/4" Bends @.70	1 40			
	1 6" 1/8" "	70			
	Sulphur & Jute	2 60			
	Trucking	75	\$11 45		
6/29/32	52 Hrs. Labor @.55	28 60			
	3 " " @.60	1 80			
	15% Overhead		4 86		
	4 Hrs. Labor @.50	2 00	32 40	6/27/32 - Reported 60.00 Refund 11.29 48.71	
Aug. 23	Refund (Sewer Receipts) Labor		48 71 11 29 60 00	11-1-30	Salido

Hadley Press, Inc., Lexington

8 12^{1/2} / 31

TOWN OF LEXINGTON—BOARD OF PUBLIC WORKS
SEWER DIVISION

DATE June 24/32

NO. 10 Charles St.


The undersigned applies for the construction of a particular sewer connecting No. 10 Charles St. Street and hereby agrees to comply with the Rules and Regulations governing the construction and use of Particular Sewers, as now or at any future time established by the Board of Selectmen.

Am't. of Estimate \$ 70⁰⁰

Am't. Paid \$ 60⁰⁰

Joseph Sousa Owner

Sketch of Service Here

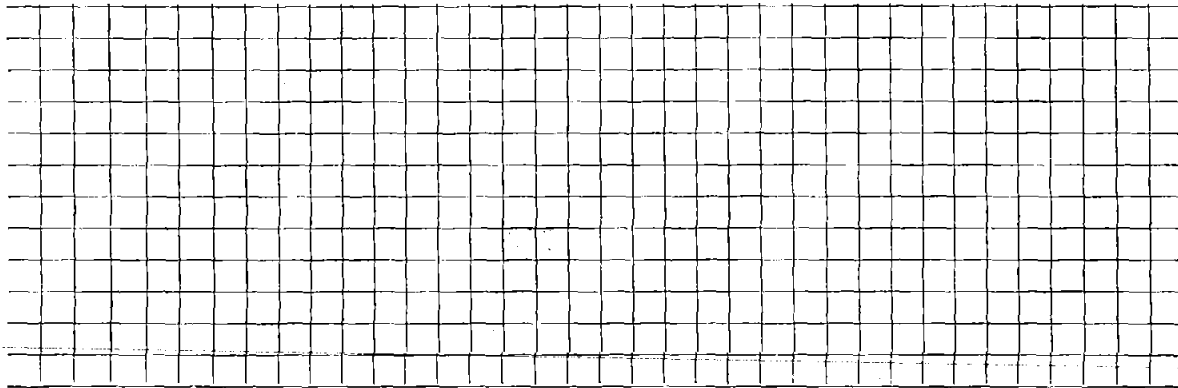

Connection made in _____ Street. Work completed _____ 19

Remarks:

Connection to be made immediately =