

Name Mrs. Bessie Ducey

Service No. 171014

Address 110 Wildwood Avenue

Arlington 74, Mass.

Location 62 Chase Avenue

Kind of Pipe

Size

Size of Main

Repair—Renewal—New Service

Location

Date	Material	Amount	Total	Date	Amount
11-7-45	Labor		10 78	Nov. 6 '45	30 00
	10% Overhead		1 08	Nov. 15 '45	3 03
	42' - 6" Sewer Pipe @.22		9 24	9-5-79	26 97
	10' - 4" Iron Pipe @.26		2 60		2 6" X 5' Nipple
	Joint Compound		2 52		2 6" X 2' Nipple
	Trucking 1 hr.		75		1 6" X 6" Nipple
			26 97		1 6" X 22 1/2° Elbow
					1 6" X 30° Bend
					1 6" Male Adapter To Clay
					1 6" Female Adapter To Clay
					1 6" X 3' Nipple
	Labor				

54

TOWN OF LEXINGTON—DEPT. OF PUBLIC WORKS

SEWER DIVISION

DATE

NO.

The undersigned applies for the construction of a particular sewer connecting No. Street and hereby agrees to comply with the Rules and Regulations governing the construction and use of Particular Sewers, as now or at any future time established by the Board of Selectmen.

Am't of estimate \$.....


Am't Paid \$.....

..... Owner

62 CHASE

Sketch of Service Here

62

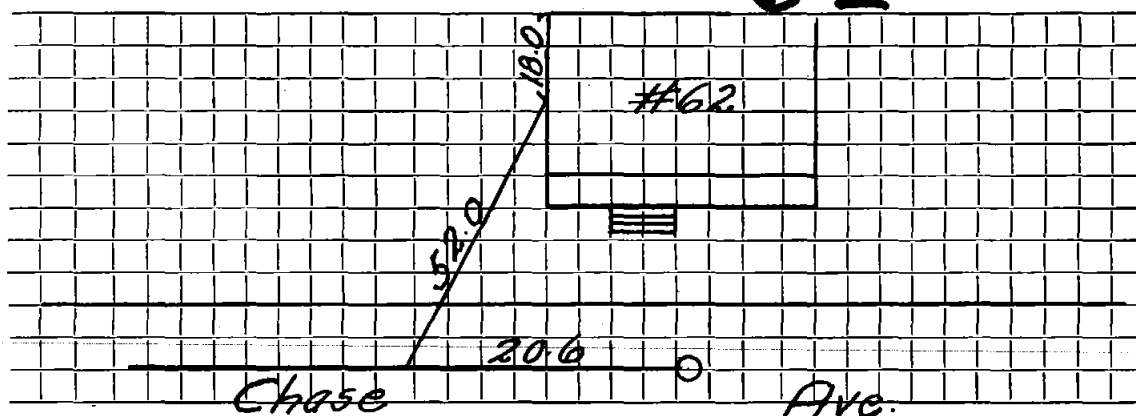

Connection made in Street.

Work completed 19..

Remarks:

