

Name Richard D. Hamilton

Service No. 146

Address 12 Chase Ave

Location

Kind of Pipe

Size

Size of Main

~~Repair Work~~ - New Service

Location *Conn 8-22-60*


Date	Material	Amount		Total		Date	Amount
7-25-60	Labor	38	22			<i>7-21-60</i>	<i>200 00</i>
	10% O.H.	3	87	42	59	<i>8-22-60</i>	<i>70 41</i>
	54' 6" Transite pipe @78			42	12		<i>129.59</i>
	1 6" Clay Elbow			1	88		
	2 Hrs Town Shovel @6.50			13	00		
	2 Hrs Trucking @3.00			6	00		
	24 x 3 Patch			24	00		
				129	59		
						<i>DEC-1964</i>	<i>Pa GS</i>

DATE _____

TOWN OF LEXINGTON — BOARD OF PUBLIC WORKS
SEWER DIVISION

Sketch of Service Here

12

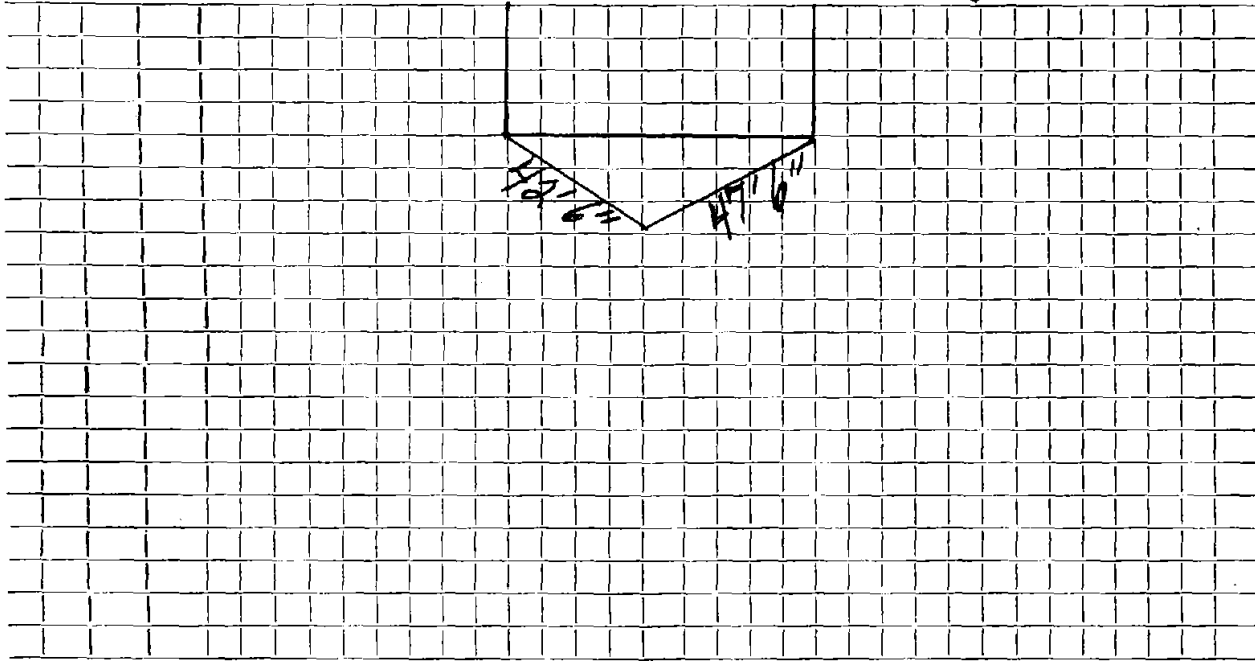

Connection made in Street. Work completed

Remarks:
.....
.....