

Name Herbert Shannon

Service No. 19 / 68

Address 17 Chase Avenue

Location 15-17 Chase Avenue

Kind of Pipe

Size

Size of Main

Repair—Renewal—New Service

Location

Date 1938	Material	Amount	Total	Date	Amount
6/7/38	14½ hrs. @ 50¢	7 25		<i>June 6, 1938 Deposited</i> <i>July 15, 1938 Refunded</i>	75 00
<i>Com 7-12-38</i>	37 " @ 55¢	20 35			63 6
	16 " @ 60¢	9 60	37 20		<u>68 64</u>
	10% Overhead		3 72		
	32' 6" Sewer Pipe @ 20¢		6 40		
	1 6 x 4 Reducer		90		
	Joint. Compound		1 92		
	3 hrs. Compressor @ 3.00	3 00	9 00		
	2 " Trucking @ .75	.75	1 50		
	Trench repairs		8 00		
			<u>\$68 64</u>		
	Labor				

Hadley Press, Inc., Lexington

TOWN OF LEXINGTON—BOARD OF PUBLIC WORKS

SEWER DIVISION

DATE June 4, 1938.

NO. _____


The undersigned applies for the construction of a particular sewer connecting No. 15+17 Chase Ave Street and hereby agrees to comply with the Rules and Regulations governing the construction and use of Particular Sewers, as now or at any future time established by the Board of Selectmen.

Am't. of Estimate \$ 75

Am't. Paid \$ _____

Mrs. Herbert Shannon Owner

Sketch of Service Here

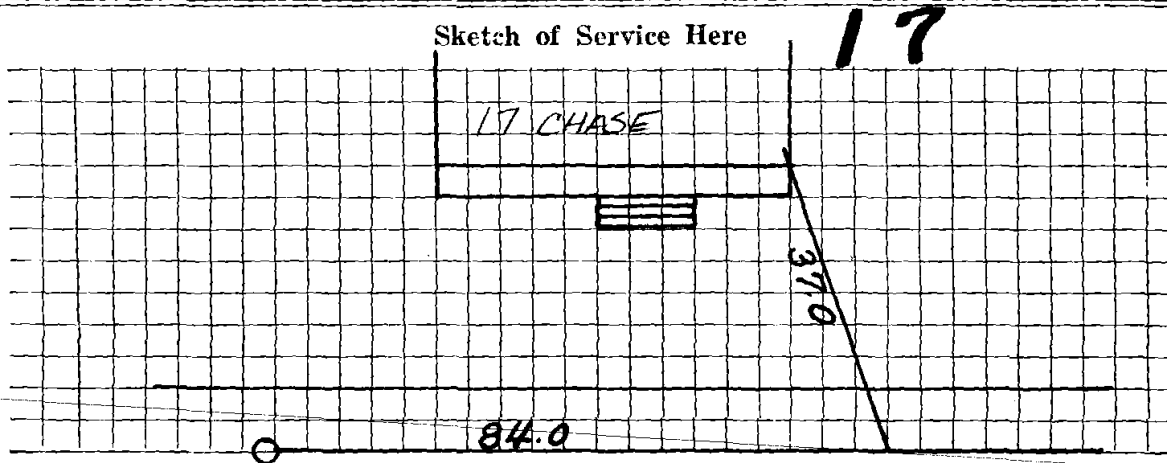

Connection made in _____ Street.

Work completed _____ 19

Remarks: