

Name Wesley Nelson

Service No. 135

Address 19 Chase Avenue

Location

Kind of Pipe

Size

Size of Main

~~Service Renewal~~ New Service W.O. #8241

Location *Comm 2-10-64*

Date	Material	Amount	Total	Date	Amount
10-24-63	Labor	94.49		10-16-63	200.00
	10% O.H.	9.45	103.94	2-10-64	24.26
	40' 6" Transite pipe @.82		32.80		175.74
	2 hrs. Town Shovel @6.50		13.00		
	2 hrs. Trucking @3.00		6.00		
	20 x 3 Patch		20.00		
			175.74		
				4-16-74	Solids & Roots 20'-28' out


DATE _____

TOWN OF LEXINGTON — BOARD OF PUBLIC WORKS

SEWER DIVISION

Sketch of Service Here

19

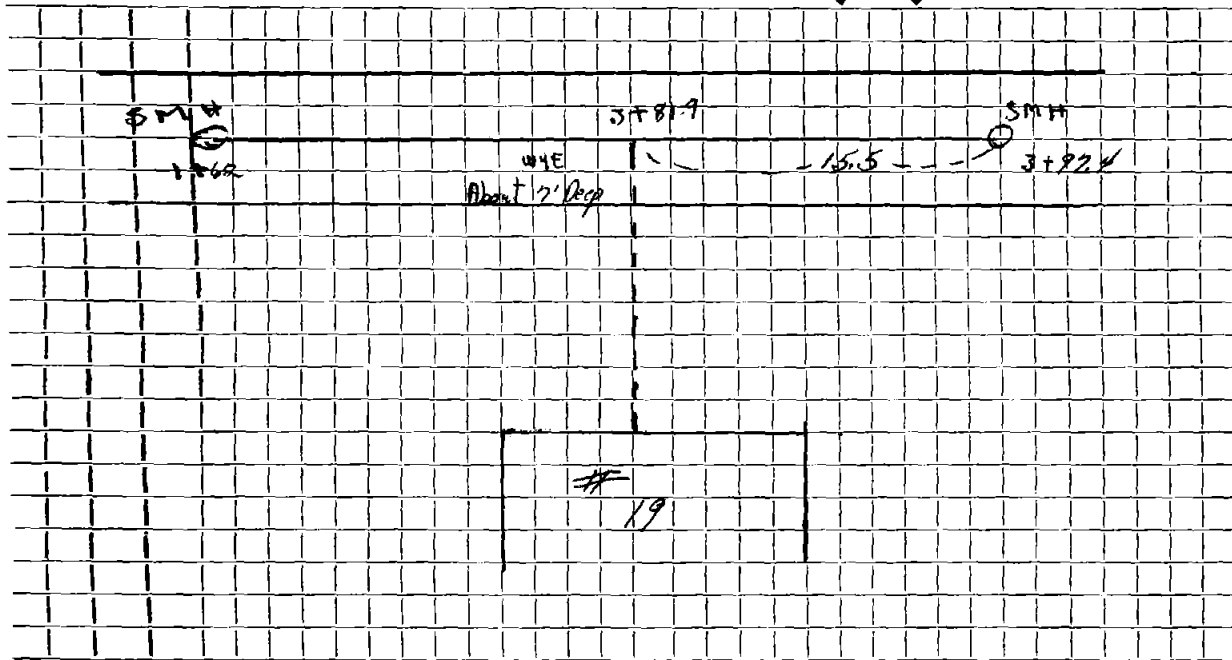

Connection made in Street. Work completed

Remarks:
.....
.....