

Name Ilda J. Field  
 Address <sup>70</sup> ~~30~~ Chase Avenue

Service No. 36 162

Location

Kind of Pipe

Size

Size of Main

~~Repair - Renewal~~ - New Service

Location

| Date     | Material                | Amount | Total | Date                | Amount |
|----------|-------------------------|--------|-------|---------------------|--------|
| 6/29/29  | 18' 6" Sewer Pipe @ .30 | 5 40   |       | Oct. 16 1929 - Cash | 68 97  |
| for 6/29 | 10' 4" Iron Pipe @ .50  | 5 00   |       |                     |        |
|          | Sulphur & Jute          | 72     |       |                     |        |
|          | Trucking                | 75     | 11 87 |                     |        |
|          |                         |        |       |                     |        |
| 6/29     | 87 Hours Labor @ .55    | 47 85  |       |                     |        |
| 3        | " " @ .60               | 1 80   | 49 65 |                     |        |
|          | 15% Overhead            |        | 7 45  |                     |        |
|          |                         |        | 68 97 |                     |        |
|          | Labor                   |        |       |                     |        |

Hadley Press, Inc., Lexington

TOWN OF LEXINGTON—BOARD OF PUBLIC WORKS

SEWER DIVISION

DATE Aug. 16, 1929

<sup>20</sup> NO. \_\_\_\_\_


The undersigned applies for the construction of a particular sewer connecting No. 30 Chase Ave. Street and hereby agrees to comply with the Rules and Regulations governing the construction and use of Particular Sewers, as now or at any future time established by the Board of Selectmen.

Am't. of Estimate \$ 50.—

Am't. Paid \$ \_\_\_\_\_

J. P. J. Field Owner

Sketch of Service Here

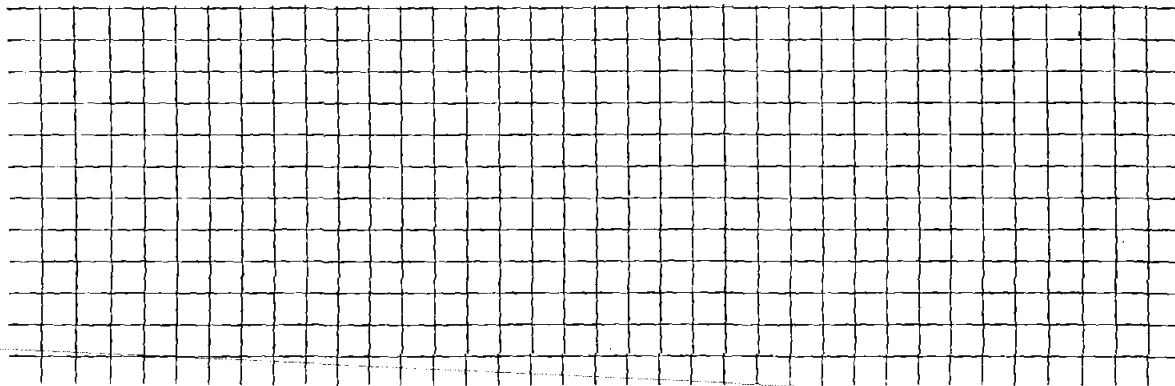

Connection made in \_\_\_\_\_ Street.

Work completed \_\_\_\_\_ 19

Remarks: