

Name Alfred Ragnelli

Service No. 56

Address 3 Chase Avenue

Location

Kind of Pipe

Size

Size of Main

~~Renewal~~ ~~New Service~~ W.O. 6598

Location

NOV 13 1978

Date	Material	Amount	Total	Date	Amount
9-20-78	Labor	75.00		9-7-78	362.00
	10% O.H.	7.50	82.50		303.26
	20' 6" Transite pipe @1.50		30.00		156.74
	1 6" x 5' Nipple @1.75		8.75		
	1 6" Nipple		1.93	9-20-78	
	1 6" x 30° Bend		11.22	10-17-78	
	1 4" Donut		3.05	1	6" x 10' Transite pipe
	1 4" Plug		3.29	1	8" x 12" 360° Clamp
	1 hr. Trucking		3.00	2	11½° Bend
	2 hrs. Backhoe		13.00		Patch 14 x 17
			156.74	8	hrs. Trucking
				1	hrs. Roller
				1	hr. Compressor
				2	hrs. Town Shovel
				8-26-68	Roots
				8-21-68	Roots


DATE \_\_\_\_\_

TOWN OF LEXINGTON — BOARD OF PUBLIC WORKS

SEWER DIVISION

Sketch of Service Here

3

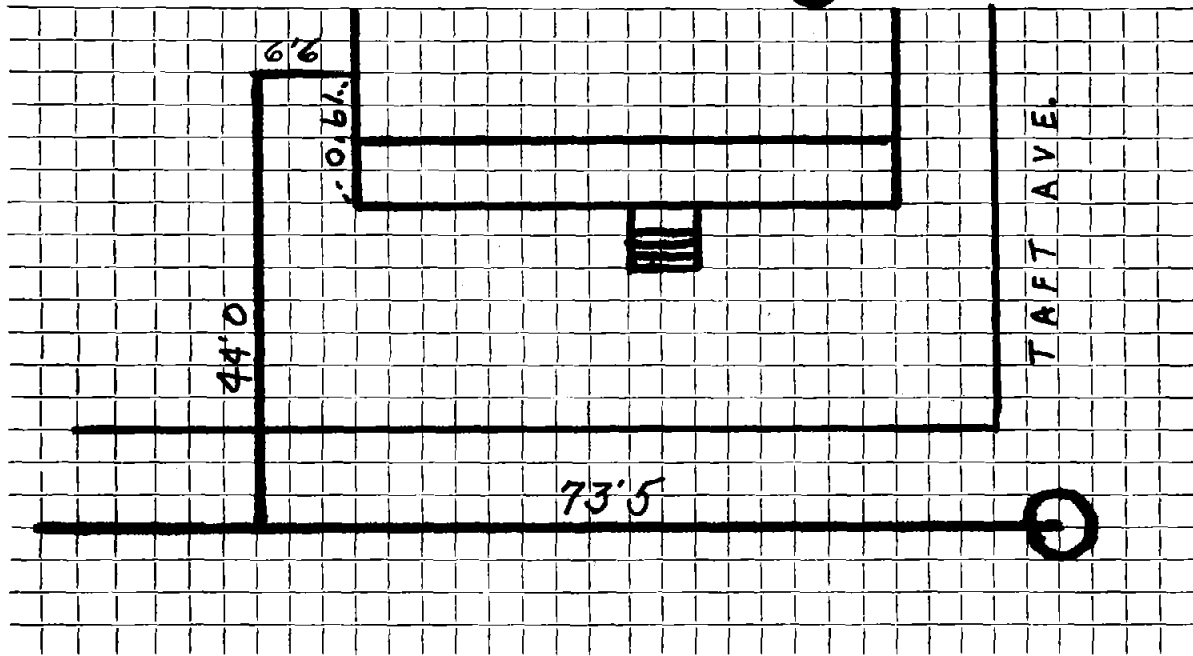

Connection made in ..... Street. Work completed .....

Remarks: .....

.....

.....