

Name

Service No.

Address

32 CHASE AVE

Location

Kind of Pipe

Size

Size of Main

Repair—Renewal—New Service

Location

Date

Material

Amount

Total

Date

Amount

6-13-02

33.5' - 6" PVC

6" - 22° PVC Bend


6x6 PVC to CLAY FINCO



DATE _____

TOWN OF LEXINGTON — BOARD OF PUBLIC WORKS
SEWER DIVISION

Sketch of Service Here

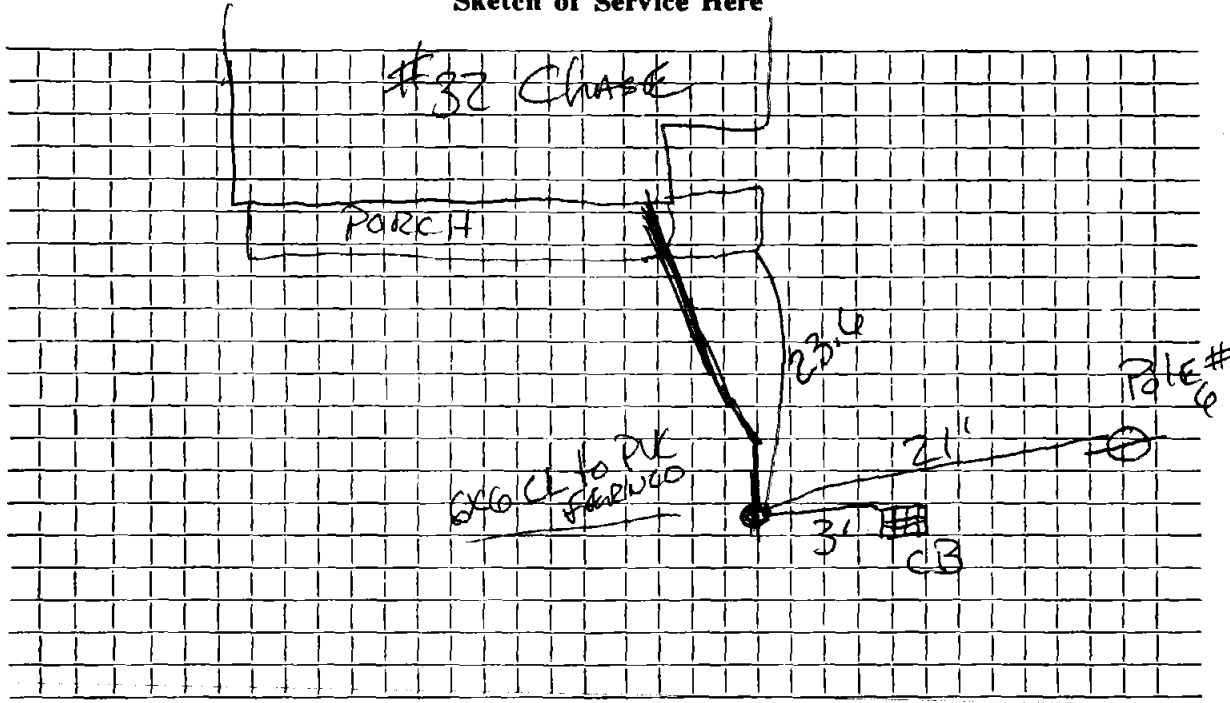

Connection made in Street. Work completed

Remarks: FRANCO UNDER CURBING
..... 5' DEEP
.....