

Name

Service No.

Address # 34 CHASE AVE. LOTS 225-226

Location

Kind of Pipe

Size

Size of Main

~~Repair~~ ~~Renewal~~ - New Service

Location

Date	Material	Amount	Total	Date	Amount
7-26-61	Labor	34 48			
	10% O.H.	3 45	37 93		
	19' 6" Transite pipe @.78		14 82		
	1 6" Clay elbow		1 88		
	2 Hrs. Town Shovel @6.50		13 00		
	2 Hrs. Trucking @3.00		6 00		NON CHARGE
	1 Hr. Loader @3.00		3 00	7-26-61	Labor 13.42
	BILL WHEN CONNECTED		76 63	7-27-61	" 28.74
					42 16


DATE \_\_\_\_\_

TOWN OF LEXINGTON — BOARD OF PUBLIC WORKS

SEWER DIVISION

Sketch of Service Here

**34**

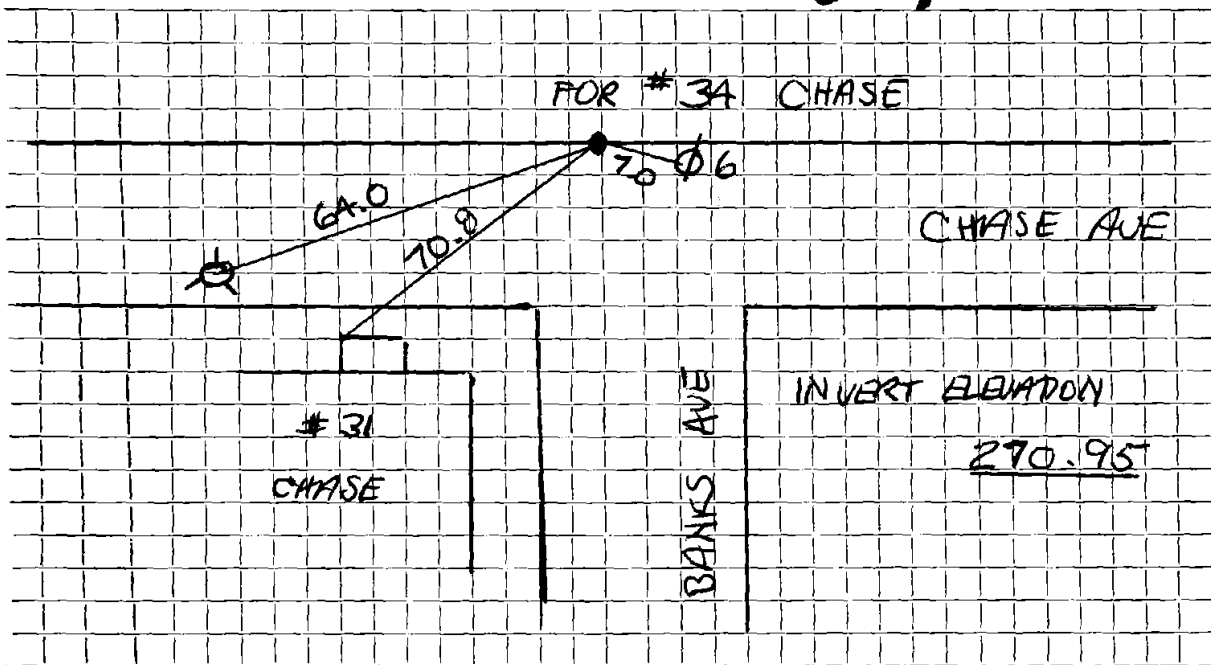

Connection made in ..... Street. Work completed .....

Remarks: .....

.....

.....