

Name

Service No.

Address 41 Chase Ave.

Location

Kind of Pipe

Size

Size of Main

Repair—Renewal—New Service

Location


Date	Material	Amount	Total	Date	Amount
	33' 6" PVC				Existing Clay
	1- 4x6 PVC/PVC Fernco				
	1- 6x6 PVC/Clay Fernco				
	1- 22° Bend				



DATE \_\_\_\_\_

**TOWN OF LEXINGTON — BOARD OF PUBLIC WORKS**  
**SEWER DIVISION**

Sketch of Service Here

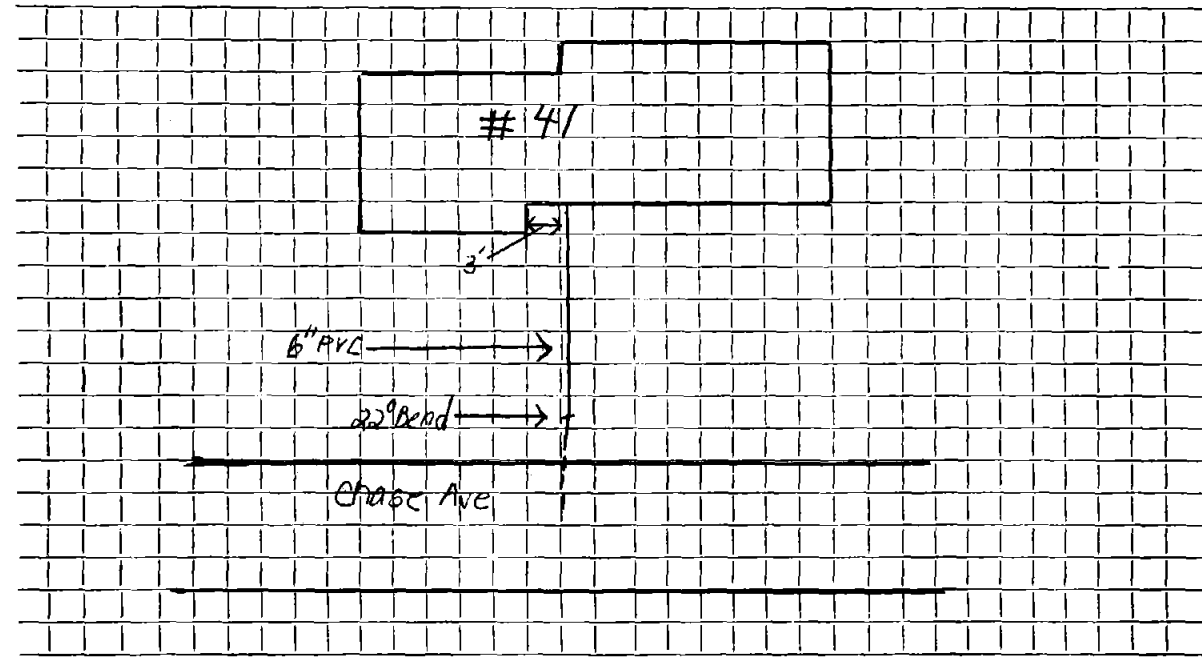

Connection made in ..... Street.      Work completed .....

Remarks: .....  
.....  
.....