

Name Donna Realty

Service No. 20

Address 42 Chase Avenue

Location

Kind of Pipe Suburbanite Cesspool Permit #A218 Size

Size of Main

~~Kind of Pipe~~ New Service W.O. #1936

Location JUN 27 1966

Date	Material	Amount	Total	Date	Amount
3-31-66	Labor	56.99		4-5-66	100 00
4-1-66	Patch	5.04		6-30-66	5 09
4-7-66	Patch	32.77	94 80	2-16-67	60 54
	10% O.H.		9 48		165 93
	20' 6" Transite pipe @ .82		16 40		
	3/4 Ton Cold patch @ 5.00		3 75		
	4 Hr. Truck @ 3.00		12 00		
	1/2 Hr. Compressor @ 5.00		2 50		
	2 1/2 Hr. Town Shovel @ 6.50		16 25		
	1/2 Hr. Town Roller @ 3.00		1 50		
	1/2 Hr. Trailer @ 2.00		1 00		
	1 1/2 Ton hot top @ 5.50		8 25		
			165 93		
4-6-66	28' 6" Transite pipe				

Deposit  
Paid by WTC # 7


DATE \_\_\_\_\_

# TOWN OF LEXINGTON — BOARD OF PUBLIC WORKS

## SEWER DIVISION

Sketch of Service Here

# 42

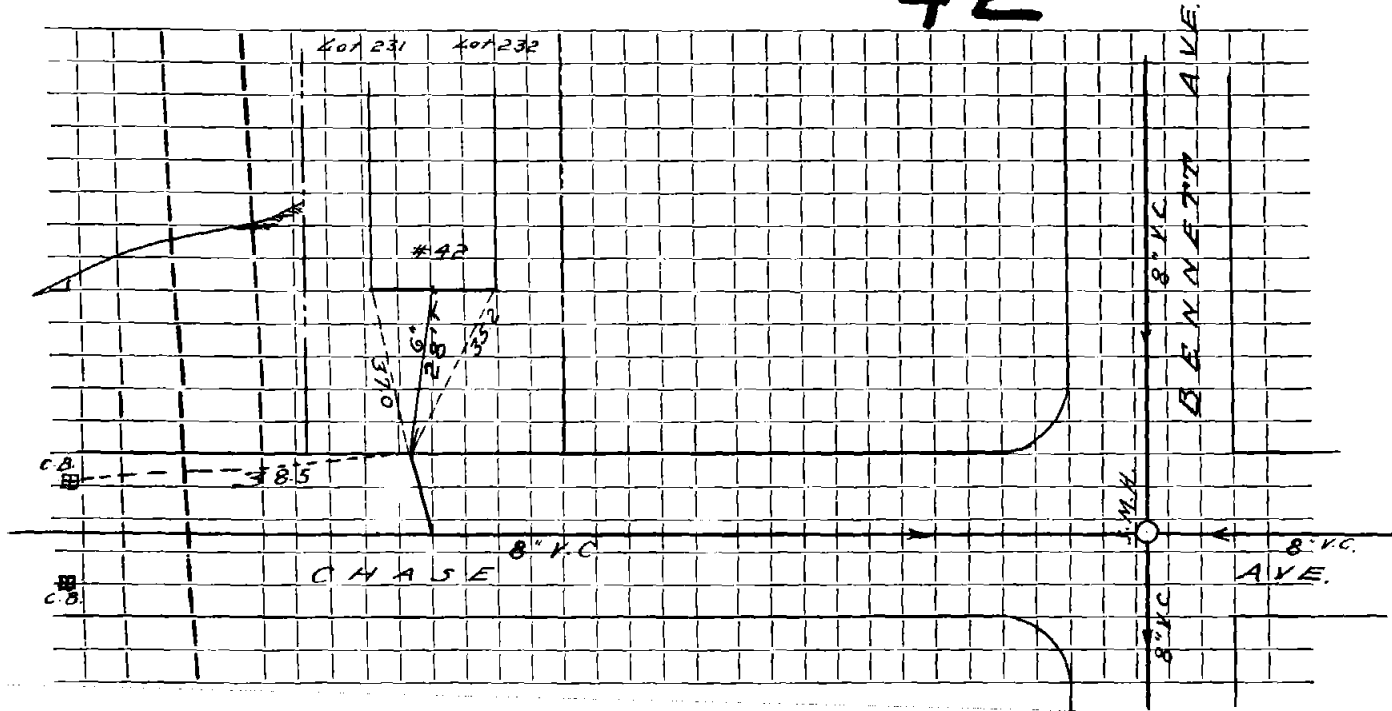

Connection made in ..... Street. Work completed .....

Remarks: .....

.....

.....