

Name Donna Realty Trust

Service No. 21

Address # ~~11~~ <sup>AA</sup> CHASE AVE. LOTS ~~231-233~~ ~~234~~ ~~235~~

Location Pt 232, 233, ~~234~~

Kind of Pipe Suburbanite Cesspool Permit #A219 Size

Size of Main

~~Repair~~ - New Service

Location MAY 2 1966


Date	Material	Amount	Total	Date	Amount
7-27-61	Labor	50 37		3-25-66	91 77
	10% O.H.	5 04	55 41		
	16' 6" Transite pipe @.78		12 48		
	1 6" Clay elbow		1 88		
	2 Hrs. Town Shovel @ 6.50		13 50		
	2 Hrs. Trucking @3.00		6 00		
	1 Hr. Loader @ 3.00		3 00		
	BILL WHEN CONNECTED		91 77		
4-7-66	29' 6" Transite pipe				

DATE \_\_\_\_\_

TOWN OF LEXINGTON -- BOARD OF PUBLIC WORKS

SEWER DIVISION

Sketch of Service Here

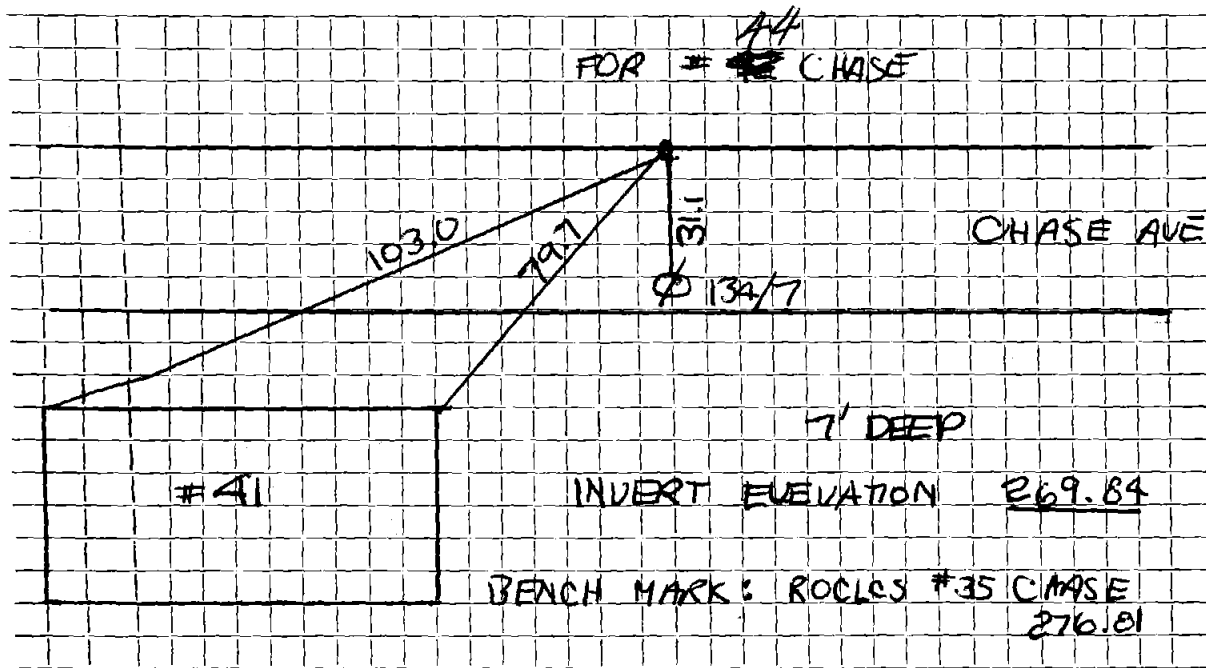

Connection made in ..... Street. Work completed .....

Remarks: .....

.....

.....