

Date	Material	Amount	Total	Date	Amount
3-31-66	Labor	33.15			100.00
4-1-66	Patch	5.04			45.84
4-7-66	Patch	44.10			145.84
11/1	6" Transite pipe @ .82		11 48		
1	6" Elbow		4 09		
3	Hr. Trucking @ 3.00		9 00		
1	Hr. Roller		3 00		
1	Hr. Trailer		2 00		
2	Ton Hot Top @ 5.50		11 00		
3/4	Ton cold patch @ 5.00		3 75		
5/8	Hr. Loader @ 4.00		2 00		
7/8	Hr. Compressor @ 5.00		2 50		
1	Hr. Shovel		6 50		
37 1/2	Transite pipe		115 84		

Name Donna Realty Trust
Address 46 Chase Avenue
Location
Kind of Pipe Size of Main
Suburbanite Permit # A220
W.O. # 1937
Location JUN 27 1966
Service No. 22


3-35-66
 Deposit
 paid
 11-4-66

DATE _____

TOWN OF LEXINGTON — BOARD OF PUBLIC WORKS
SEWER DIVISION

Sketch of Service Here

46

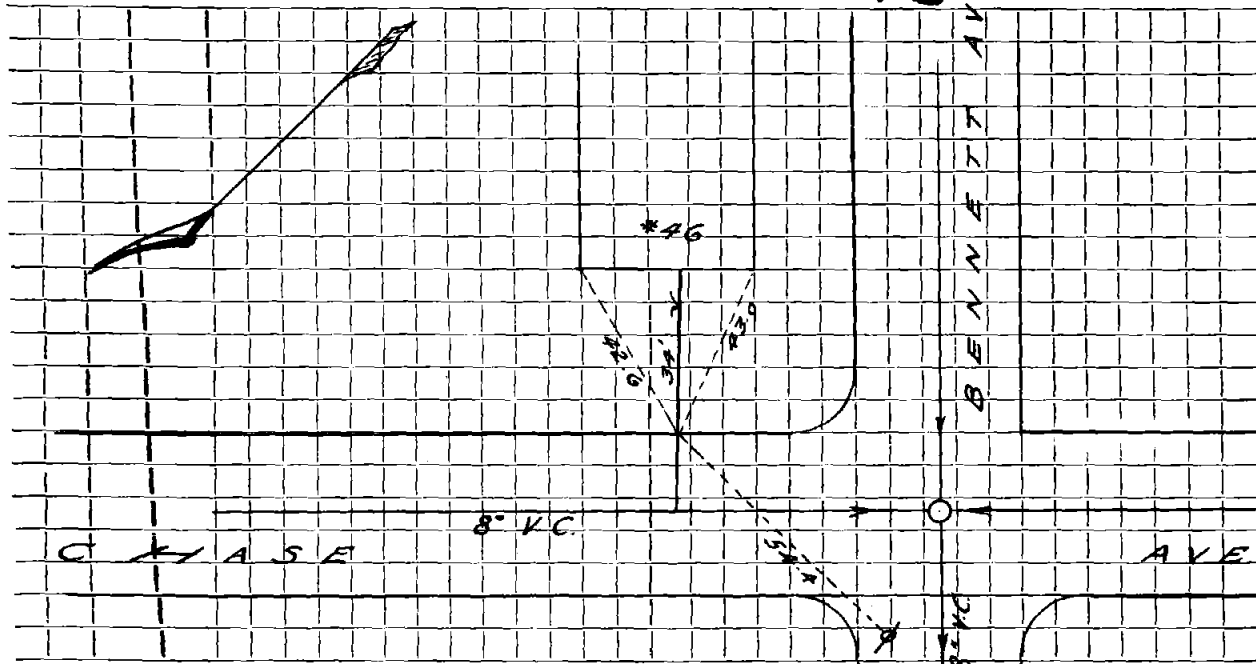

Connection made in Street. Work completed

Remarks:
.....
.....