

Name Malcolm H. Clifford.

Service No. 9 163

Address 54 Chase Avenue, Lexington,

Location

Kind of Pipe

Size

Size of Main

~~Repair - Rework~~ New Service

Location

Date 1943	Material	Amount	Total	Date	Amount
May 25	14 hrs. @ 55¢	7 70		May 12, 1943	Deposited 90 00
May 6/43	49 1/2 " @ 65¢	32 18		Jan 6, 1944	Paid 11 73
	16 1/2 " @ 70¢	11 55			8.1 73
	16 1/2 " @ 80¢	13 20	64 63		
	10% overhead		6 46		
	26' 6" Sewer Pipe @ 16¢		4 16		
	1 6" 1/8 Bend		67		
	Joint compound		1 56		
	1 hr. compressor		2 25		
	Trucking - 2 hrs. @ 75¢		1 50		
			81 23		
	Labor				

Hadley Press, Inc., Lexington

144771 Plugged Sewer Sludge

TOWN OF LEXINGTON—BOARD OF PUBLIC WORKS

SEWER DIVISION

DATE May 15, 1943


NO. _____

The undersigned applies for the construction of a particular sewer connecting No. 54 Chase Ave. Street and hereby agrees to comply with the Rules and Regulations governing the construction and use of Particular Sewers, as now or at any future time established by the Board of Selectmen.

Am't. of Estimate \$ _____

Am't. Paid \$ _____

Malcolm H. Clifford Owner

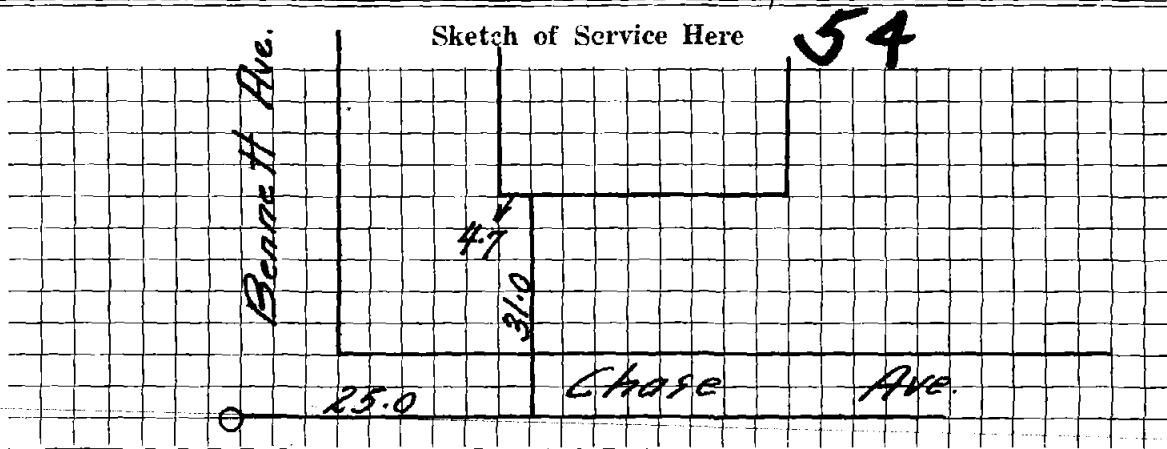

Connection made in _____ Street. Work completed _____ 19

Remarks: