

Name

Service No.

Address 57 Chase Avenue

Lots 248-249 - Sta. 1+0 right

Location

Kind of Pipe

Size

Size of Main

~~Repair~~ New Service W.O. #847


Location

Date	Material	Amount	Total	Date	Amount
9-9-65	Labor	10 96			
9-10-65	Labor	64 05			
	10% O.H.	7 50	82 51		
	20' 6" Transite pipe @.82		16 40		
	1 Hr. Town Truck		3 00		
	4 Hrs. Town Tractor @ 6.50		26 00		
			127 91		

DATE _____

TOWN OF LEXINGTON — BOARD OF PUBLIC WORKS
SEWER DIVISION

Sketch of Service Here **57**

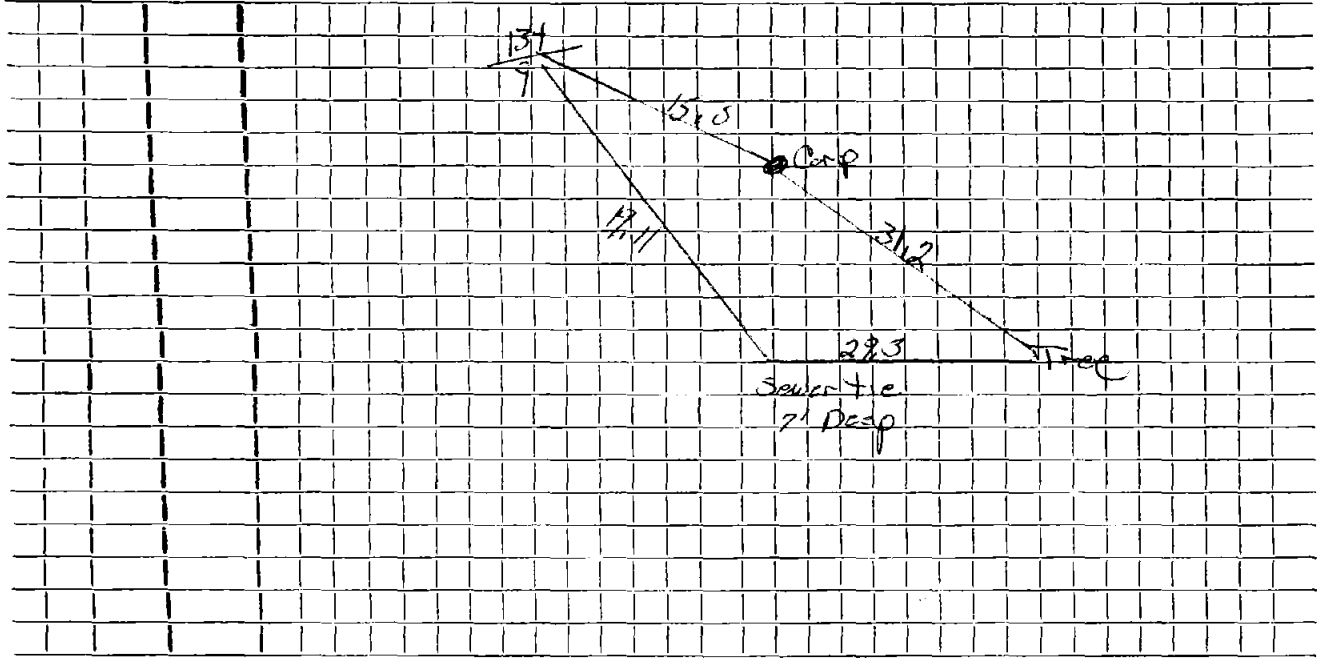

Connection made in Street. Work completed

Remarks:
.....
.....

