

Name John E. Keddy

Service No. 177

Address 59 Chase Avenue

Location

Kind of Pipe

Size

Size of Main

~~REPAIR/RENEWAL~~—New Service WO #7704


Location *Comm 1-14-63*

Date	Material	Amount	Total	Date	Amount
11-7-62	Labor	36.95		11-1-62	200.00
11-13-62	"	41.96	78.91	1-14-63	27.15
	10% O.H.	7.89	86.80		172.85
	53' 6" Transite pipe @82		43.46		
	1 90° Transite Elbow		4.09		
	5 Hrs. Town Shovel @6.50		32.50		
	2 Hrs. Trucking @3.00		6.00		
			172.85		

DATE _____

TOWN OF LEXINGTON — BOARD OF PUBLIC WORKS
SEWER DIVISION

Sketch of Service Here **59**

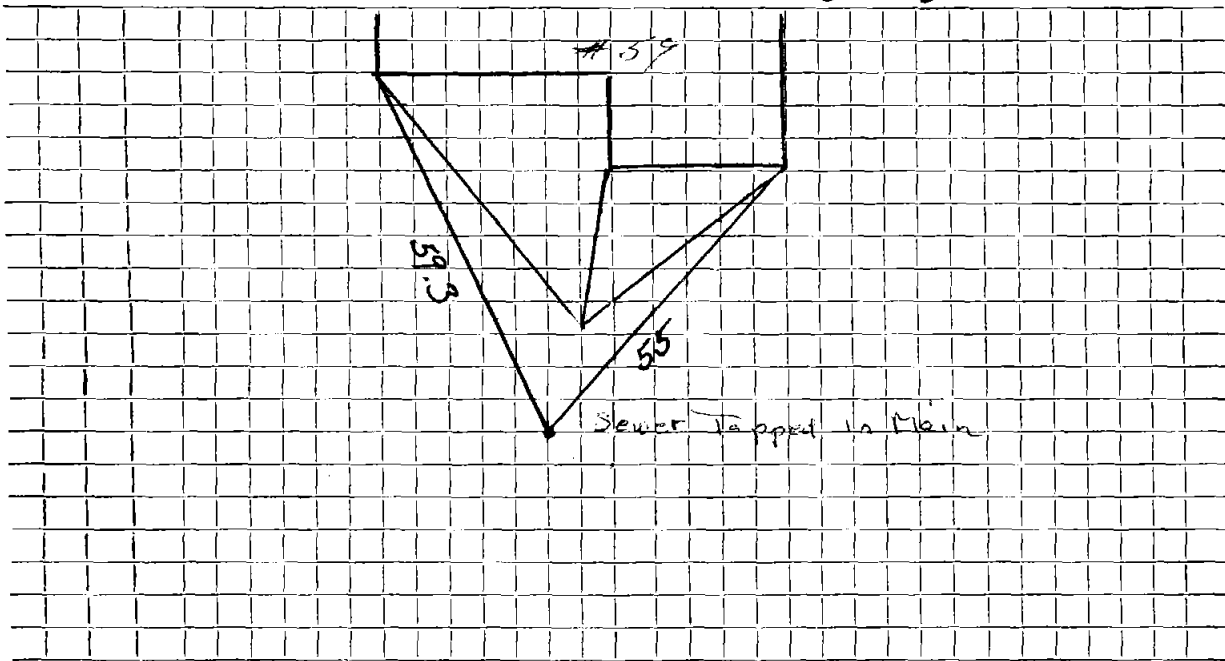

Connection made in Street. Work completed

Remarks:
.....
.....