

Name Clarence H. MacIntosh

Service No. 8 1009

Address 60 Chase Avenue

Lexington, Mass.

Location 60 Chase Avenue

Kind of Pipe

Size

Size of Main

~~Repair~~ ~~Renewal~~ — New Service

Location

Date	Material	Amount	Total	Date	Amount
May 2, '45	Labor	32 34		April 27 '45	70 00
May 3, '45	"	23 34	55 68	June 25 '45	5 25
	10% Overhead		5 57		75 25
	20' 6" Sewer Pipe @.32		4 40		
	10' - 4" Soil Pipe @.50		5 00		
	1 - 6" Elbow		70		
	Joint Compound		2 40		
	Trucking 2 hrs. @.75		1 50		
			75 25		
				2-13-68	Proto
	Labor				

TOWN OF LEXINGTON—DEPT. OF PUBLIC WORKS

SEWER DIVISION

DATE

NO.

The undersigned applies for the construction of a particular sewer connecting No. Street and hereby agrees to comply with the Rules and Regulations governing the construction and use of Particular Sewers, as now or at any future time established by the Board of Selectmen.


Am't of estimate \$.....

Am't Paid \$.....

..... Owner

Sketch of Service Here

60

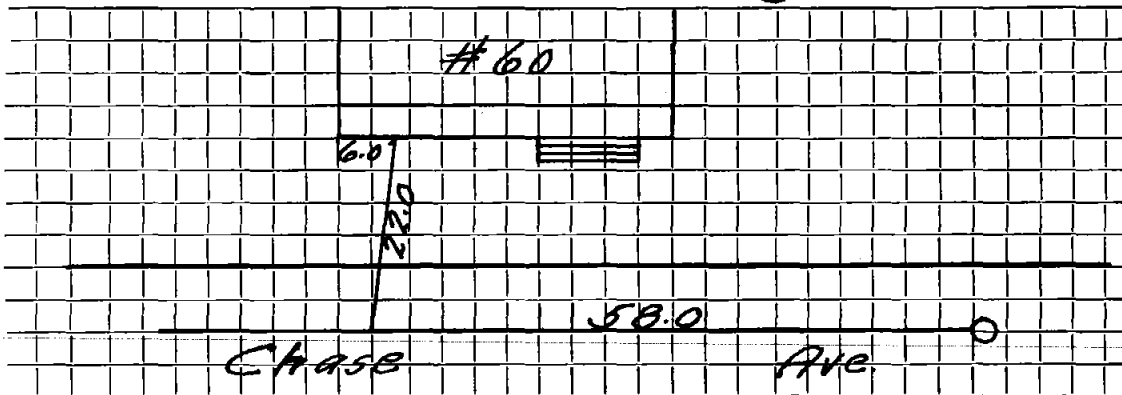

Connection made in Street.

Work completed 19..

Remarks: