

Name Ralph Cork

Service No.

1081

Address 10 Cherry Street

Lexington, Mass.

Location 10 Cherry Street

Kind of Pipe

Size

Size of Main

Repair - Renewal - New Service

Location

Date	Material	Amount	Total	Date		Amount
Jul. 19 '47	Labor	31 73				
21	"	17 80	49 53	Jul. 2 '47	Deposited	90 00
	10% Overhead		4 95	Nov. 29 '47	Refunded	20 58
	28' - 6" Sewer Pipe @ .26		9 88			69 42
	1 - 6" 1/8 Bend		1 28			
	Joint Compound		2 28			
	Trucking 2 hr. @ .75		1 50			
			69 42			
	Labor					

TOWN OF LEXINGTON—DEPT. OF PUBLIC WORKS

SEWER DIVISION

DATE

NO.

The undersigned applies for the construction of a particular sewer connecting No.
Street and hereby agrees to comply with the Rules and Regulations governing the construction and use of Particular
Sewers, as now or at any future time established by the Board of Selectmen.


Am't of estimate \$.....

Am't Paid \$.....

..... Owner

Sketch of Service Here

10

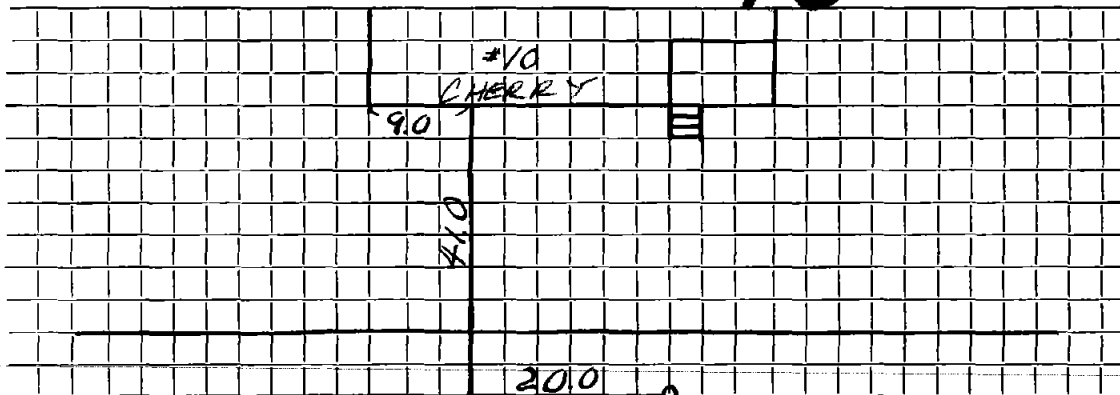

Connection made in Street.

Work completed 19..

Remarks:

