

Name Louis Bonadio

Service No. 130

Address 11 Cherry Street

Location

Kind of Pipe

Size

Size of Main

~~REPAIR WORK~~ - New Service

Location *Comm 8-22-60*

Date	Material	Amount	Total	Date		Amount
7-25-60	Labor	91 60		7-18-60	Deposit	200 00
	10 % O.H.	9 16	100 76	8-22-60	Refund	8 72
	64' 6" Transite pipe@78		49 92			191 28
	1 1 1/4" Transite bend		5 10			
	3 Hrs. Town shovel@.50		19 50			
	2 Hrs. Trucking@3.00		6 00			
	10 x 3 Patch		10 00			
			191 28			

Name Louis Bonadio

Service No. 130

Address 11 Cherry Street

Location

Kind of Pipe

Size

Size of Main

~~Repair~~ New Service

Location *Conn 8-22-60*

Date	Material	Amount	Total	Date	Amount
7-25-60	Labor	91 60		7-18-60	200 00
	10 % O.H.	9 16	100 76	8-22-60	8 72
	64' 6" Transite pipe@78		49 92		191 28
	1 1 1/4" Transite bend		5 10		
	3 Hrs. Town shovel@6.50		19 50		
	2 Hrs. Trucking@3.00		6 00		
	10 x 3 Patch		10 00		
			191 28		

DATE _____

TOWN OF LEXINGTON — BOARD OF PUBLIC WORKS

SEWER DIVISION

Sketch of Service Here

A large grid of graph paper, approximately 20 columns wide and 25 rows high, intended for sketching service details.

Connection made in Street. Work completed

Remarks:
.....
.....

TOWN OF LEXINGTON—DEPT. OF PUBLIC WORKS
SEWER DIVISION

DATE

NO.

The undersigned applies for the construction of a particular sewer connecting No.
Street and hereby agrees to comply with the Rules and Regulations governing the construction and use of Particular
Sewers, as now or at any future time established by the Board of Selectmen.


Am't of estimate \$.....

Am't Paid \$.....

..... Owner

Sketch of Service Here

12

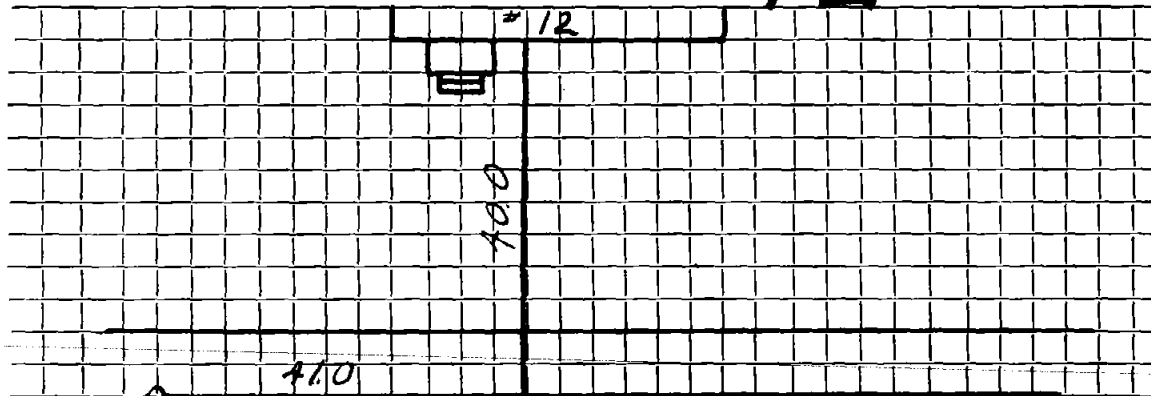

Connection made in Street.

Work completed 19..

Remarks: