

Name John Sachetti

Service No. 1068

Address 12 Cherry Street

Lexington, Mass.

Location 12 Cherry Street

Kind of Pipe

Size

Size of Main

~~Repair~~ ~~Renewal~~ - New Service

Location

Date		Material	Amount	Total	Date	Amount
Apr. 30,	'47	Labor	27 20		Apr 25 '47	90 00
May 1,	'47	"	23 40		May 22 '47	3 56
May 2,	'47	"	13 62	64 22		86 44
		10% Overhead		6 42		
		36' - 6" Sewer Pipe @.24		8 64		
		Joint Compound		2 16		
		Compressor 2 hrs. @1.75		3 50		
		Trucking 2 hrs. @.75		1 50		
				86 44		
		Labor				

TOWN OF LEXINGTON—DEPT. OF PUBLIC WORKS
SEWER DIVISION

DATE

NO.


The undersigned applies for the construction of a particular sewer connecting No.
Street and hereby agrees to comply with the Rules and Regulations governing the construction and use of Particular
Sewers, as now or at any future time established by the Board of Selectmen.

Am't of estimate \$.....

Am't Paid \$.....

..... Owner

Sketch of Service Here **12**

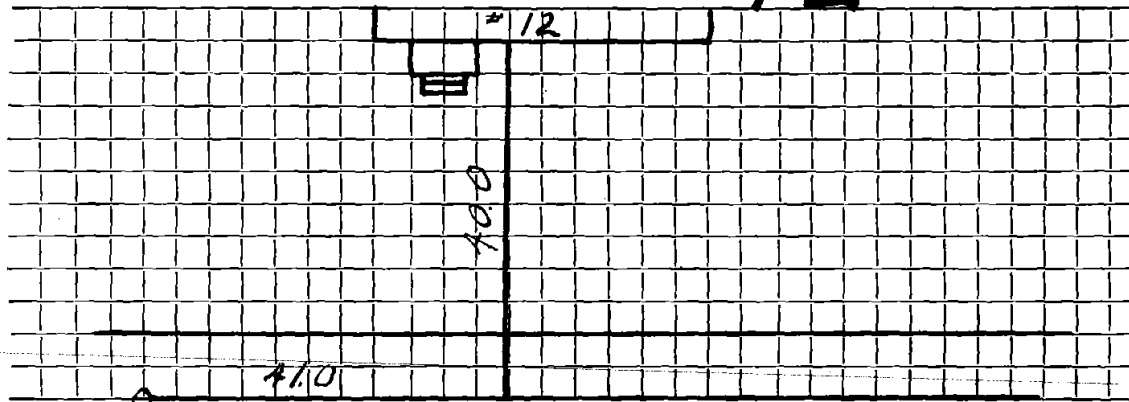

Connection made in Street.

Work completed 19..

Remarks: