

Name

Service No.

Address 14 Cherry Street

Lexington, Mass.

Location 14 Cherry Street

Kind of Pipe

Size

Size of Main

~~Repair or Renewal~~ - New Service To be billed when service connected

Location

Date	Material	Amount	Total	Date	Amount
Sept. 11, '47	Labor	9 80			
Sept. 12, '47	"	<u>22 87</u>	32 67		
	10% Overhead		3 27		
	18' - 6" Sewer Pipe @.26		4 68		
	Joint Compound		1 08		
	Trucking 2 hrs. @.75		<u>1 50</u>		
			43 20		
11-12-98	Inside hooked up				
	10' 4" PVC				
	13' 6" PVC				
	6" - 22° Band				
	Labor 6" x 4" PVC to PVC FERNCO				
	6" x 6" PVC to Clay FERNCO				

TOWN OF LEXINGTON—DEPT. OF PUBLIC WORKS

SEWER DIVISION

DATE

NO.

The undersigned applies for the construction of a particular sewer connecting No.
Street and hereby agrees to comply with the Rules and Regulations governing the construction and use of Particular
Sewers, as now or at any future time established by the Board of Selectmen.

Am't of estimate \$.....


Am't Paid \$.....

..... Owner

Service to curb

Sketch of Service Here

14

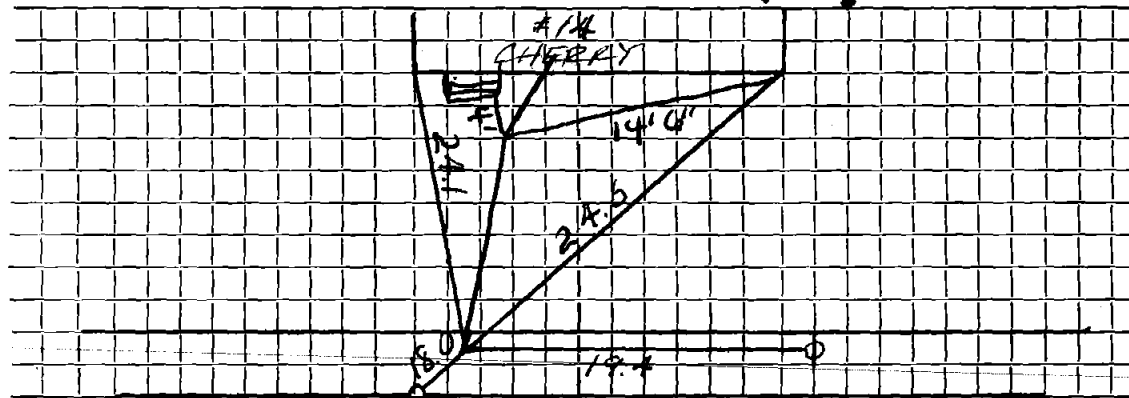

Connection made in *Cherry* Street.

St. Work completed 19..

Remarks: