

Name Harry E. Johnson
 Address 1070 Mass. Ave., Arlington

Service No. ~~11~~ 166

Location Lot #⁴~~40~~ Cherry St. - ~~Don right~~

Kind of Pipe

Size

Size of Main

~~Excise Renewal~~ - New Service

Location

Date	Material	Amount	Total	Date	Amount
Sept. '34	34' 6" S. Pipe @ .27	\$9 18			
Comm. 15.60 to Russell 15.60 - 17/31/34	Sulphur & Jute Trucking	1 36 <u>75</u>	\$11 29	Aug. 25 1934	Deposit 15 60
	Estimated cost:				
	39' @ .40	\$15 60	<u>\$15 60</u>		
	Labor				

Hadley Press, Inc., Lexington

TOWN OF LEXINGTON—BOARD OF PUBLIC WORKS
SEWER DIVISION

DATE Aug 24 1934

NO. _____


The undersigned applies for the construction of a particular sewer connecting No. Lot 40 Cherry St Street and hereby agrees to comply with the Rules and Regulations governing the construction and use of Particular Sewers, as now or at any future time established by the Board of Selectmen.

Am't. of Estimate \$ 15.60

Am't. Paid \$ _____

Harry E. Johnson Owner

Sketch of Service Here

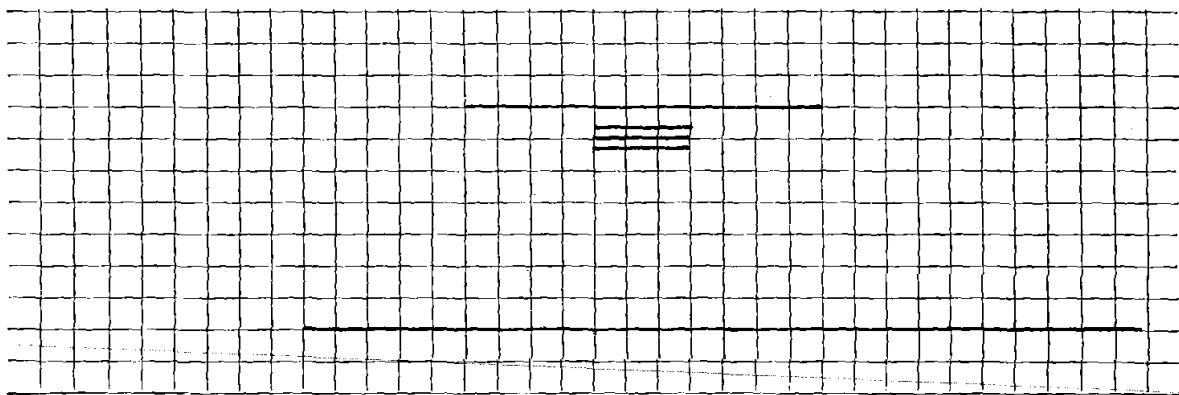

Connection made in _____ Street. Work completed _____ 19

Remarks: Sewer 39 ft