

Name Ivar D. Johnson

Service No. 6 164

Address 36 Fordham St., Arlington

Location Lot #43 Cherry Street

Kind of Pipe

Size

Size of Main

~~Repair - Renewal~~ New Service

Location

Date	Material	Amount	Total	Date	Amount
1935					
June 3	4 Hrs. Labor @ 50¢	2 00		May 10 1935	20 00
<i>30m. to Russell</i>	16 " " @ 55¢	8 80		Nov. 29 1935	55
<i>4-16-35 1-30-81</i>	8 " " @ 60¢	4 80	15 60	Nov 29 1935	3 11
	10% Overhead		1 56	Aug. 19, 1936	7 15
	42' 6" Sewer Pipe @ 20¢	8 40		Cash	30 81
	Sulphur & Jute	75			
	Trucking 3 hrs. @ \$1.50	4 50	13 65		
			30 81		
	Labor				

Hadley Press, Inc., Lexington

TOWN OF LEXINGTON—BOARD OF PUBLIC WORKS

SEWER DIVISION

DATE May 10 1935


NO. \_\_\_\_\_

The undersigned applies for the construction of a particular sewer connecting No. Lat # 43 Cherry Street Street and hereby agrees to comply with the Rules and Regulations governing the construction and use of Particular Sewers, as now or at any future time established by the Board of Selectmen.

Am't. of Estimate \$ 70.00

Am't. Paid \$ \_\_\_\_\_

Wm. D. Johnson Owner

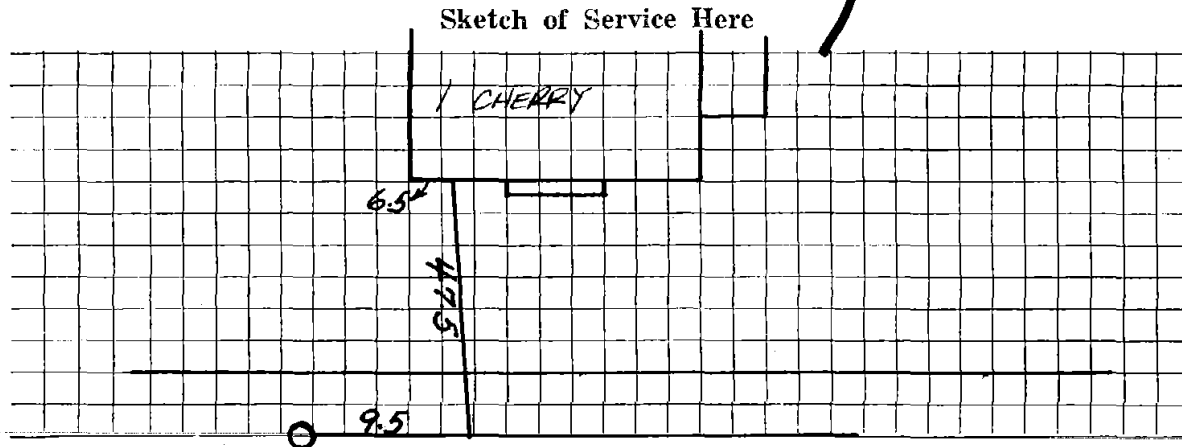

Connection made in \_\_\_\_\_ Street.

Work completed \_\_\_\_\_ 19

Remarks: