

Name

Service No.

Address **5 Cherry Street**

Location **5 Cherry Street**

Kind of Pipe

Size

Size of Main

Repair—Renewal—New Service

Location

Date

Material

Amount

Total

Date

Amount

**3-11-42**

**42 6" Sewer Pipe**

**5-2-07**

**Main blocked  
118' up from M H  
on Talt**

Labor

TOWN OF LEXINGTON—BOARD OF PUBLIC WORKS  
SEWER DIVISION

DATE \_\_\_\_\_


NO. \_\_\_\_\_

The undersigned applies for the construction of a particular sewer connecting No. 5 Cherry St.  
Street and hereby agrees to comply with the Rules and Regulations governing the construction and use of Particular  
Sewers, as now or at any future time established by the Board of Selectmen.

Am't. of Estimate \$ \_\_\_\_\_

Am't. Paid \$ \_\_\_\_\_

\_\_\_\_\_  
Owner

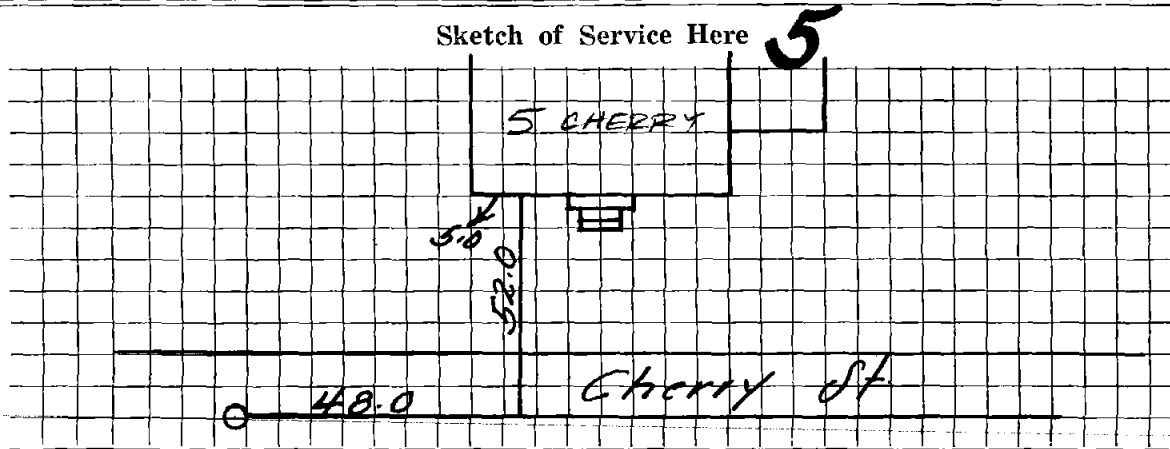

Connection made in \_\_\_\_\_ Street.

Work completed \_\_\_\_\_ 19

Remarks: