

Name Lida M. Ssi

Service No. 1073

Address 7 Cherry Street

Lexington, Mass.

Location 7 Cherry Street

Kind of Pipe

Size

Size of Main

~~Repair~~ ~~Renewal~~ New Service

Location

Date		Material	Amount		Total		Date		Amount	
May 23,	47	Labor	20	37			May 19	47	Deposited	110 00
24		"	39	17			Nov 29	47	Refunded	22 41
25		"	25	23	60	04				87 59
		10% Overhead			6	00				
		53' - 8" Sewer Pipe	0.06	✓	13	78				
		1 - 8" 1/3 Band		✓	1	23				
		Joint Compound			3	24				
		Compressor	2.75			75				
		Trucking 2 hrs.	0.75		1	50				
					<del>77</del>	59				
		Labor								

TOWN OF LEXINGTON—DEPT. OF PUBLIC WORKS  
**SEWER DIVISION**

DATE .....

NO. ....

The undersigned applies for the construction of a particular sewer connecting No. ....  
Street and hereby agrees to comply with the Rules and Regulations governing the construction and use of Particular  
Sewers, as now or at any future time established by the Board of Selectmen.


Am't of estimate \$. ....

Am't Paid \$. ....

*400 new feet  
16 00*

..... Owner

Sketch of Service Here

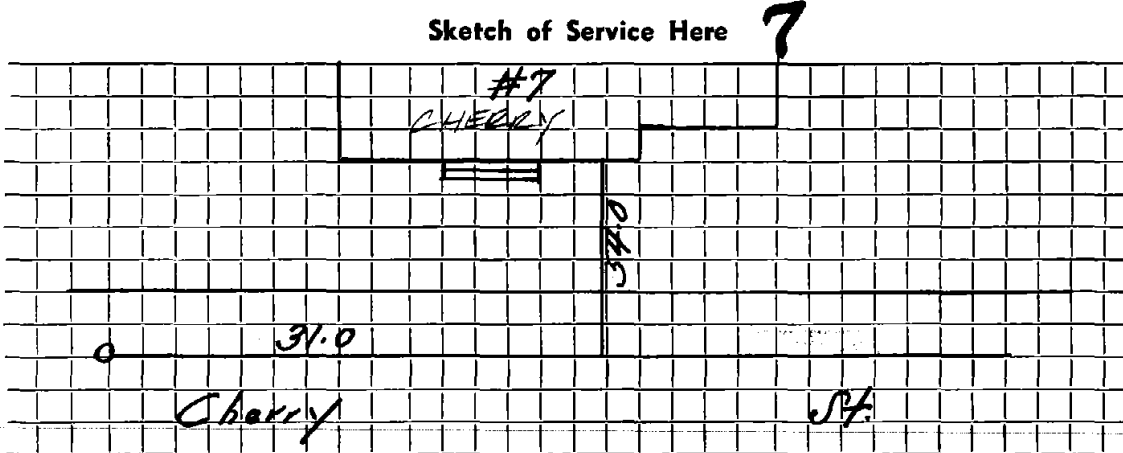

Connection made in ..... Street.

Work completed ..... 19..

Remarks: