

Name **Leeland Construction Co.**

Service No. **113**

Address **( 18 Childs Rd.**

Location

Kind of Pipe

Size

Size of Main

~~Repair & Renewal~~ **New Service**

Location *Cem. 11-24-58*

| Date   | Material                           | Amount | Total  | Date     | Amount |
|--------|------------------------------------|--------|--------|----------|--------|
| 7/3/58 | Lab or                             | 32 78  |        | 6-25-58  | 150 50 |
| 7/7/58 | Lab or                             | 33 27  |        | 11-24-58 | 17 64  |
|        |                                    | 66 05  |        |          | 132 36 |
|        | 10% Overhead                       | 6 61   | 72 66  |          |        |
|        | 48'-6" Transite Pipe @.70          |        | 33 60  |          |        |
|        | 1-11 $\frac{1}{4}$ " Transite Bend |        | 5 10   |          |        |
|        | 3 hrs. Town Shovel @ 6.50          |        | 19 50  |          |        |
|        | 2 hrs. Trucking @.75               |        | 1 50   |          |        |
|        |                                    |        | 132 36 |          |        |
|        | <b>Labor</b>                       |        |        |          |        |

**TOWN OF LEXINGTON—DEPT. OF PUBLIC WORKS**  
**SEWER DIVISION**

DATE.....

NO. ....

The undersigned applies for the construction of a particular sewer connecting No.....  
Street and hereby agrees to comply with the Rules and Regulations governing the construction and use of Particular  
Sewer, as now or at any future time established by the Board of Selectmen.


Am't of estimate \$.....

Am't Paid \$.....

..... Owner

---

**Sketch of Service Here**

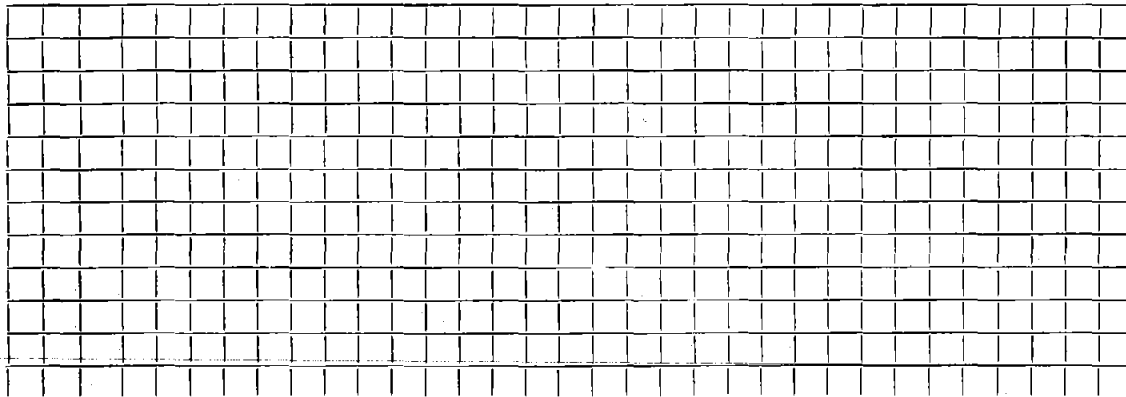

Connection made in..... Street.

Work completed.....19..

Remarks:

