

Name Jenkins Realty Inc.

Service No. 101

Address 19 Childs Road

Location

Kind of Pipe

Size

Size of Main

Repair—Renewal—New Service DeFlice Bros. Permit #390

Location

SEP 27 1965

Date		Material	Amount	Total		Date		Amount	
		6" Transite pipe	estimated	40	00	7-19-65	Deposit	40	00
7-21-65	33'	6" Transite pipe							


H.B.M.18501

DATE \_\_\_\_\_

# TOWN OF LEXINGTON — BOARD OF PUBLIC WORKS

## SEWER DIVISION

Sketch of Service Here **19**

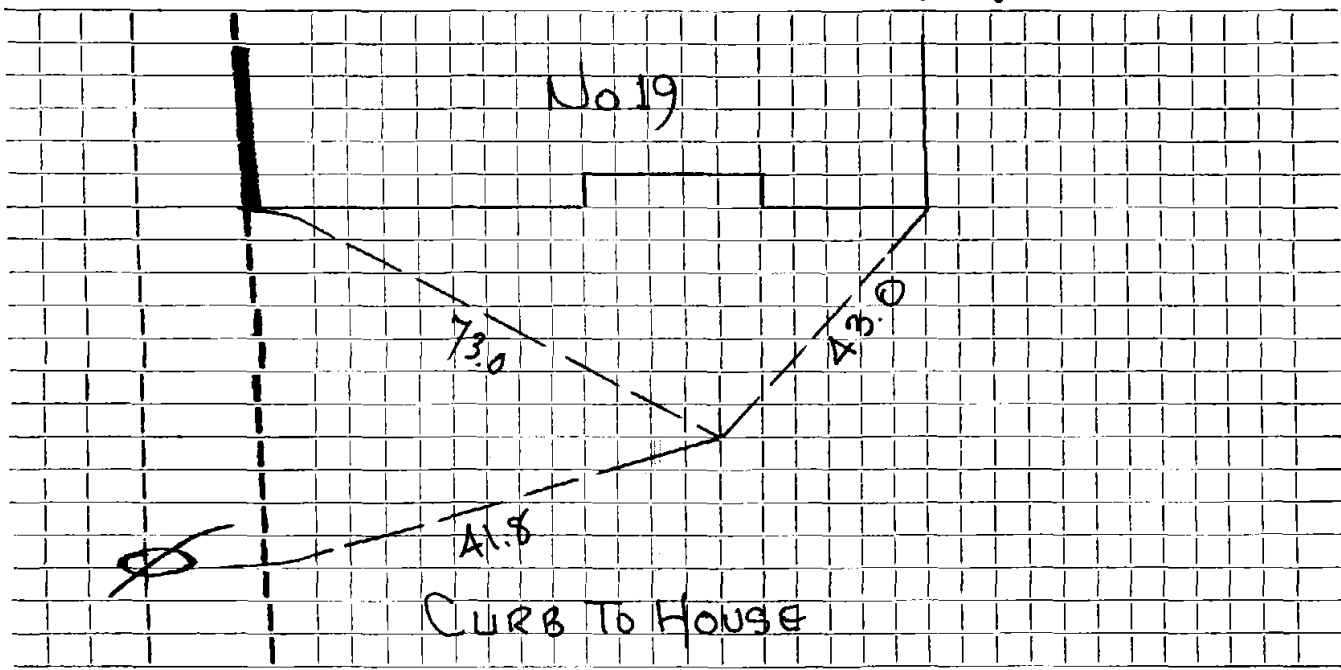

Connection made in ..... Street. Work completed .....

Remarks: .....  
.....  
.....

