

Name Newton C. Schoenly

Service No. 122

Address 4 Childs Road

Comm. 12-3-56

Location Service was in to curb

Kind of Pipe

Size

Size of Main

~~Repair/Renewal~~ - New Service

Location

| Date | Material | Amount | Total | Date | Amount |
|---------|----------------------------------|--------|--------|---------|--------------------------|
| 9/10/56 | Labor | 14 85 | | 8-28-56 | Deposit \$ 225 00 |
| " | " | 62 35 | | 12-3-56 | Refund 71 74 |
| | | 77 20 | | | 153 26 |
| | 10% Overhead | 7 72 | 84 92 | | |
| | 82' - 6" Sewer Pipe @ .435 | | 35 67 | | |
| | Joint compound | | 4 92 | | |
| | 3 hrs. Littlefield Shovel @ 8.50 | | 25 50 | | |
| | 3 hrs. trucking @ .75 | | 2 25 | | |
| | | | 153 26 | | |
| | Labor | | | 5-18-80 | Solids |
| | | | | 4-4-94 | Roots |
| | | | | 3-26-99 | Roots 38'-42' in service |

TOWN OF LEXINGTON—DEPT. OF PUBLIC WORKS
SEWER DIVISION

DATE

NO.


The undersigned applies for the construction of a particular sewer connecting No.
Street and hereby agrees to comply with the Rules and Regulations governing the construction and use of Particular
Sewers, as now or at any future time established by the Board of Selectmen.

Am't of estimate \$.....

Am't Paid \$.....

..... Owner

Sketch of Service Here

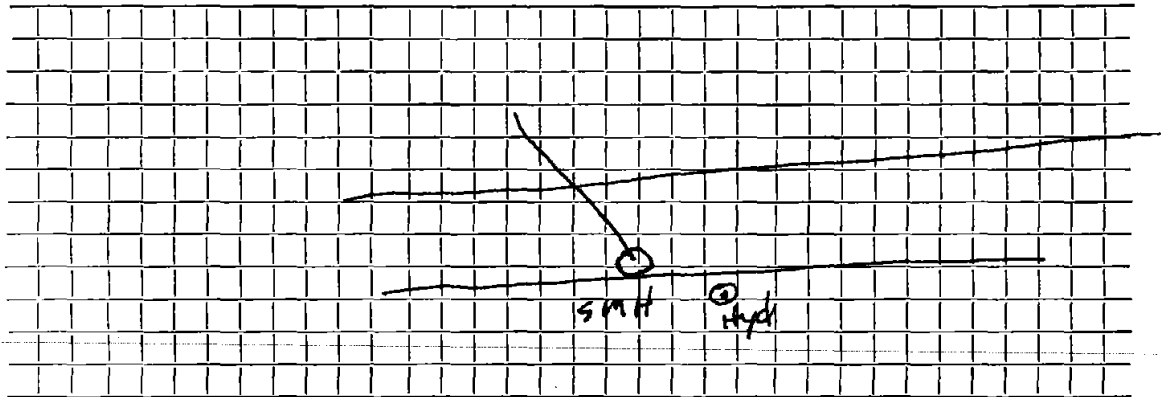

Connection made in Street. Work completed 19..

Remarks: SERVICE CAN BE FLUSHED FROM
M.H.