

Name Frank Currier

Service No.

Address 4 Churchill Lane

Location

Kind of Pipe Valeri Const. Co.

Size

Size of Main

~~Repair Renewal~~ New Service Permit #A232

Location


Date		Material	Amount		Total	Date		Amount	
Mar '66		Connect to Easement							
4-15-66	60'	6" Transite pipe							

DATE _____

TOWN OF LEXINGTON — BOARD OF PUBLIC WORKS

SEWER DIVISION

Sketch of Service Here **4**

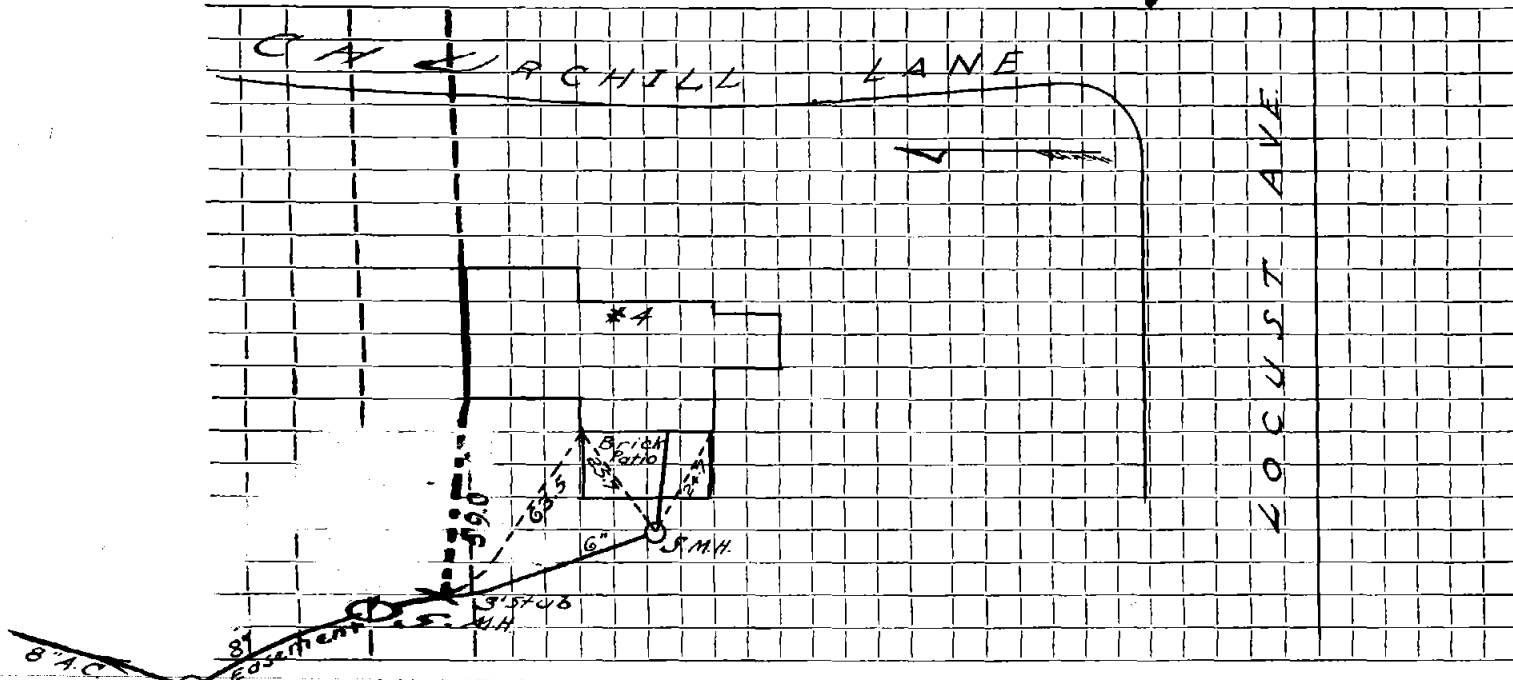

Connection made in Street. Work completed

Remarks: