


DATE MAY 22 1998

TOWN OF LEXINGTON — BOARD OF PUBLIC WORKS

SEWER DIVISION

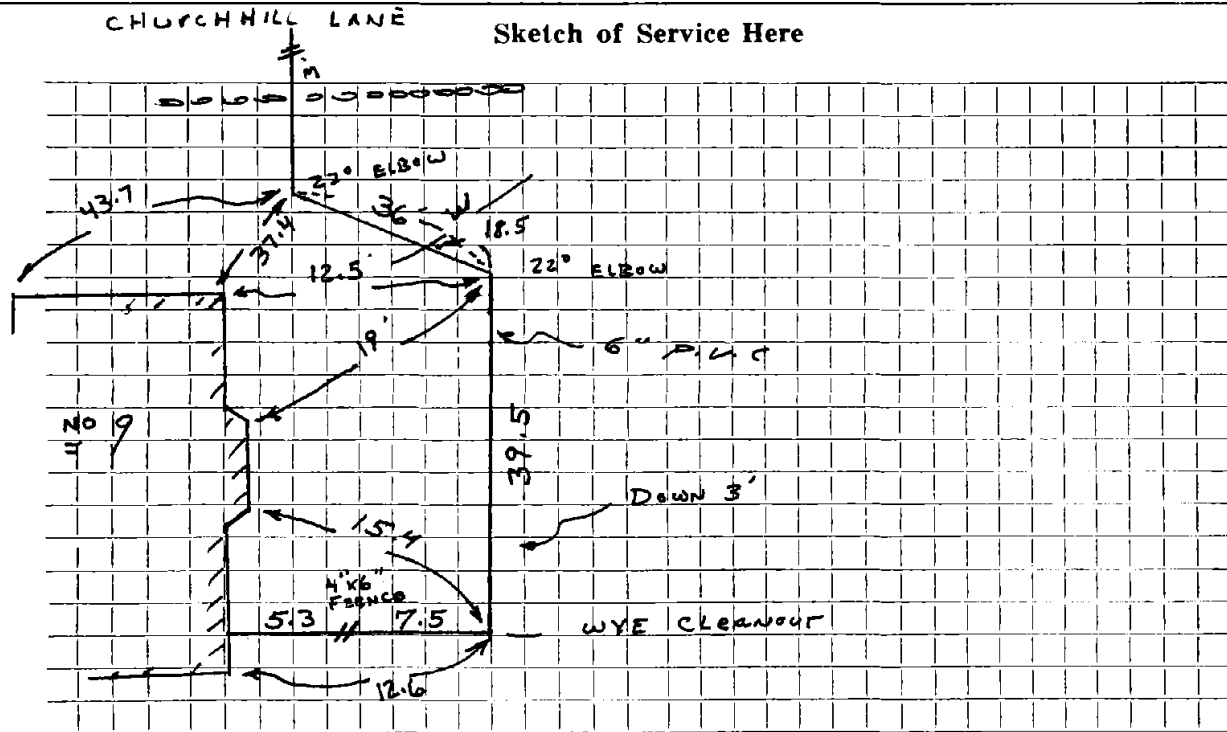


Connection made in CHURCH HILL LANE Street. Work completed SUBURBANITE

Remarks: FIELD BOOK 98-1 T.M.

DATE _____

TOWN OF LEXINGTON — BOARD OF PUBLIC WORKS
SEWER DIVISION

Sketch of Service Here **9**

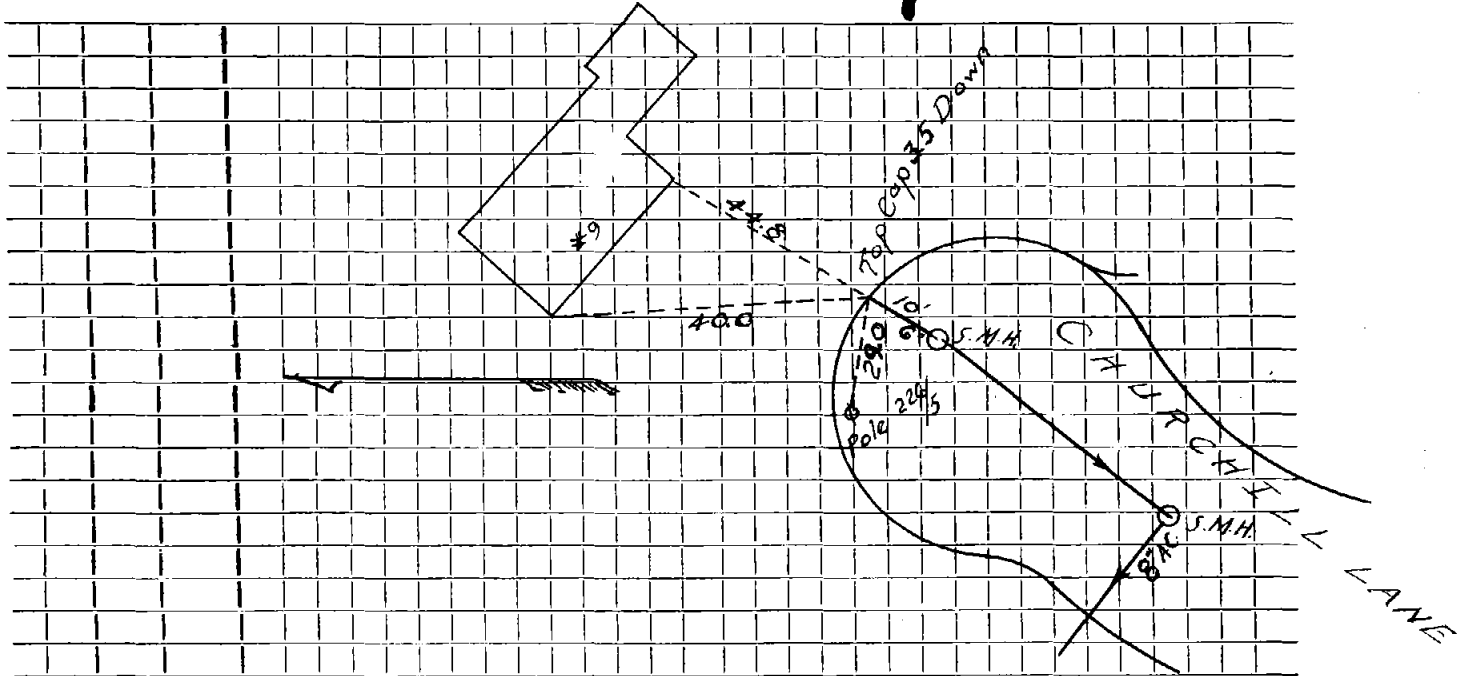

Connection made in Street. Work completed

Remarks:
.....
.....