

Name

Service No.

Address 10 CHURCHILL

Location

Kind of Pipe SDR 35

Size 6" PVC

Size of Main

Repair—~~Renewal~~—New Service

Location


Date	Material	Amount	Total	Date	Amount
	6" SDR	20'			
	4"x6" FERRO				
	4' CHIMNEY				

DATE _____

TOWN OF LEXINGTON — BOARD OF PUBLIC WORKS

SEWER DIVISION

Sketch of Service Here ← CHURCHILL RD →

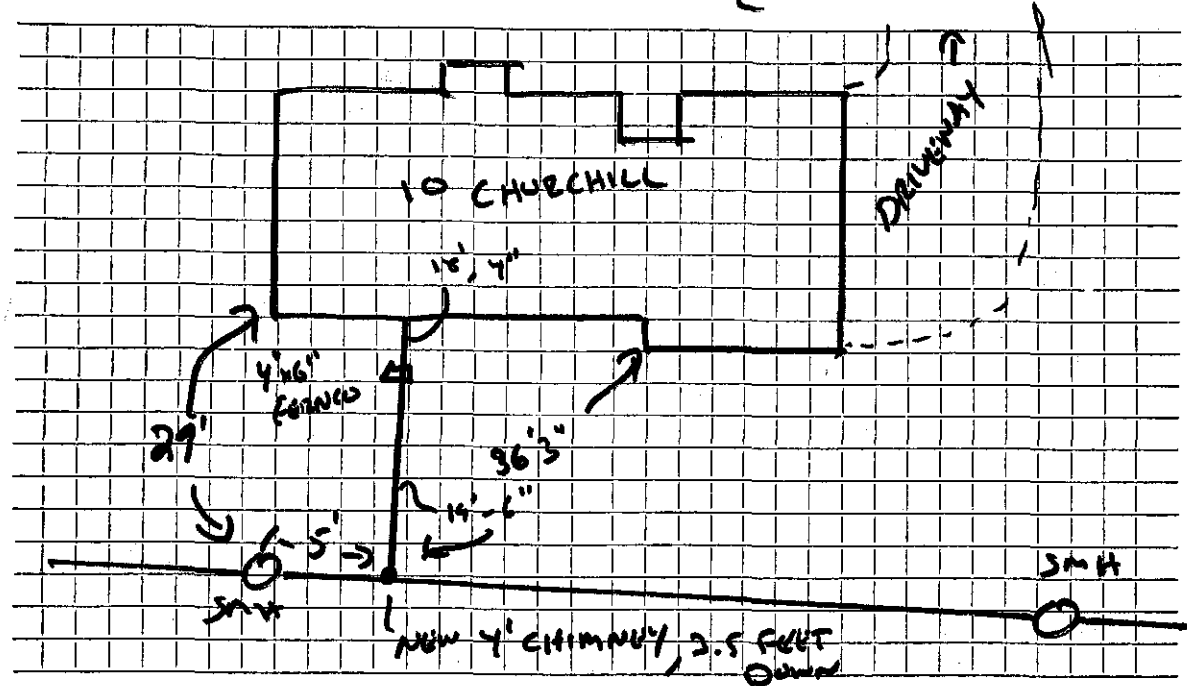

Connection made in Street. Work completed ... 10VINO

Remarks:

.....

.....