




DATE July 2003

**TOWN OF LEXINGTON — BOARD OF PUBLIC WORKS**  
**SEWER DIVISION**

Sketch of Service Here

LOT 13

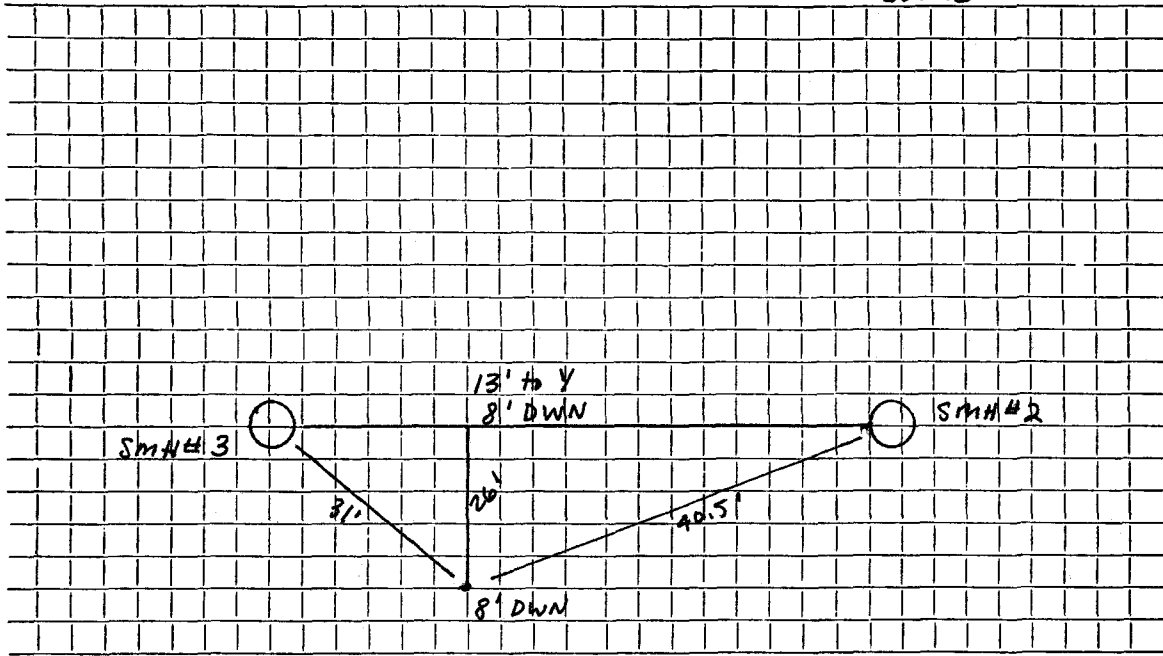

Connection made in ..... Street. Work completed .....

Remarks: .....  
.....  
.....