


DATE July 2003

TOWN OF LEXINGTON — BOARD OF PUBLIC WORKS
SEWER DIVISION

Sketch of Service Here

LOT 11

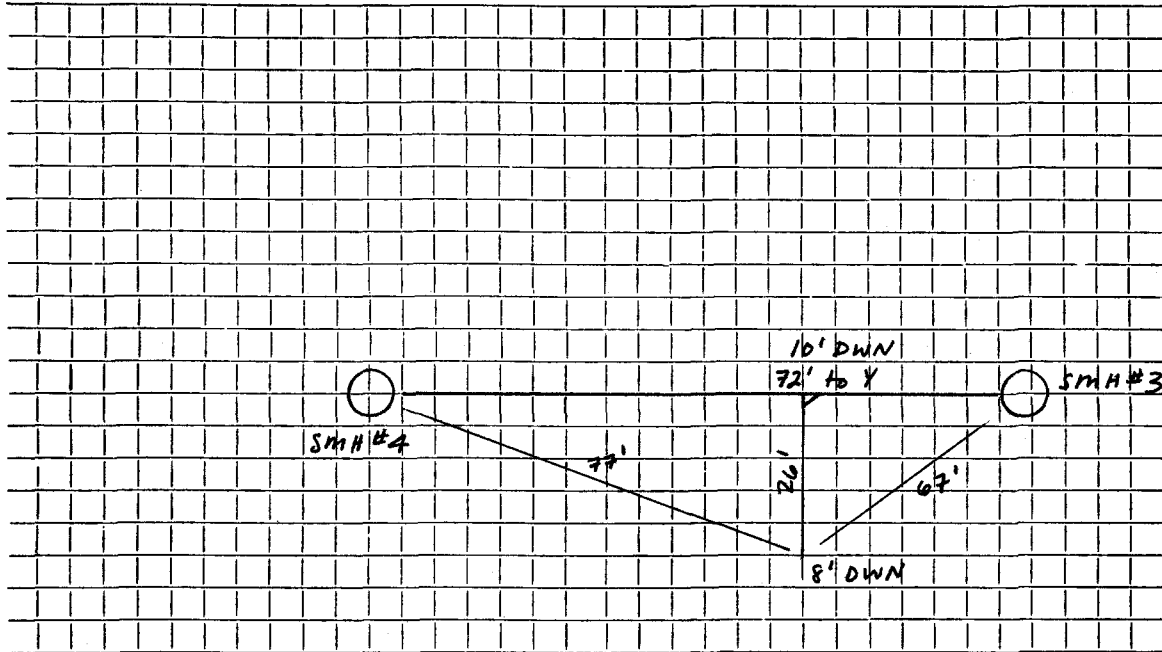

Connection made in Street. Work completed

Remarks:

.....

.....