

Name

Service No.

Address 17 Cider Mill Lane Johnson Farm

Location Lot # 10

Kind of Pipe PVC

Size 6"

Size of Main

Repair—Renewal—New Service

Location

Date		Material	Amount		Total	Date		Amount	
9/03	1	8x6 Wye							
	51'	6" PVC							
	6'	4"							
	1	4x6 Ferruco							




DATE _____

TOWN OF LEXINGTON — BOARD OF PUBLIC WORKS
SEWER DIVISION

Sketch of Service Here

LOT 10

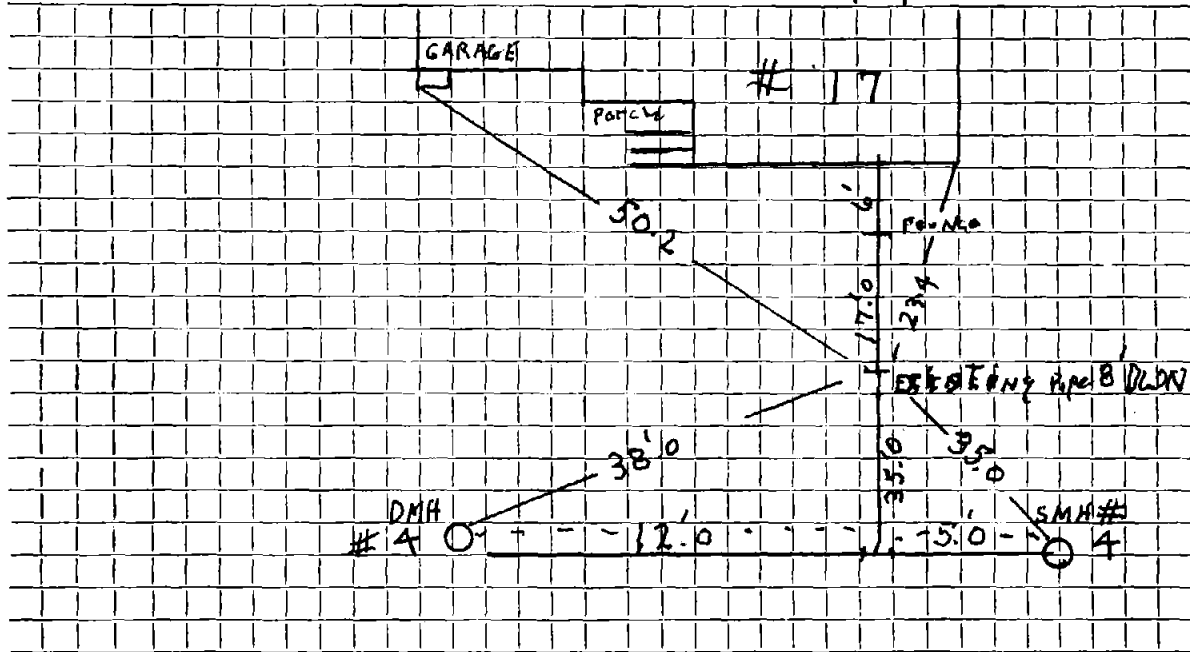

Connection made in Street. Work completed 9/03

Remarks: DAVE PAV. INSP.

.....