

Name

Service No.

Address 6 Cider Mill LA

LOT #1

Location

Kind of Pipe PVC

Size

Size of Main

Repair—Renewal—New Service

Location

Date

Material

Amount

Total

Date

Amount

9/03

4" sch 40

6" PVC


4x6 FENCE

DATE \_\_\_\_\_

TOWN OF LEXINGTON — BOARD OF PUBLIC WORKS  
SEWER DIVISION

Sketch of Service Here

Lot 1

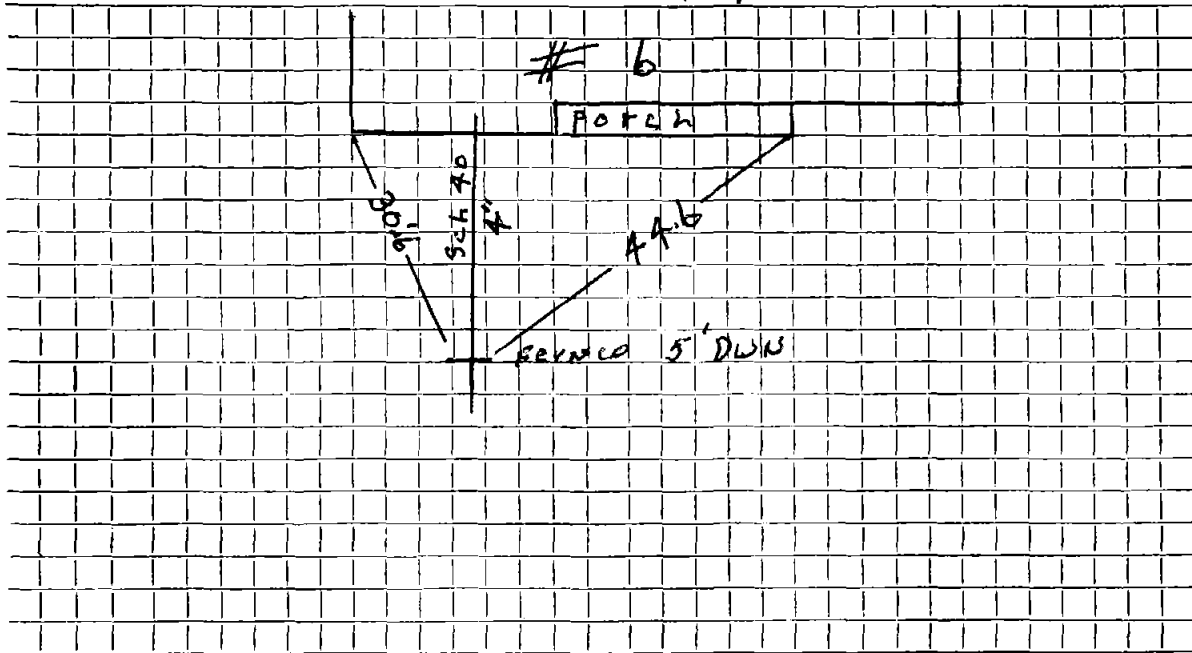

Connection made in ..... Street. Work completed 9/24/03 .....

Remarks: Dave Pan .....

.....  
.....