
Service No. Name Scott Properties Address 11 Circle Road Location Size of Main Kind of Pipe Size Repair—Renewal—New Service Location Date Material Amount Total **Amount** Date 1975 INSTALLED BY CONTRACTOR H.B.M.18501

DAT	E	 	

TOWN OF LEXINGTON - BOARD OF PUBLIC WORKS

SEWER DIVISION

Sketch of Service Here

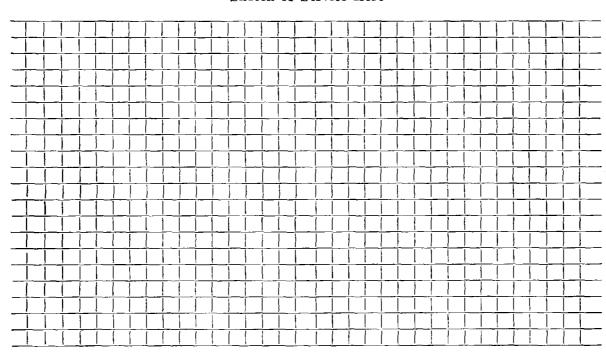

Connection made in	Street.	Work completed	
Remarks:			