

Name Busa Realty

Service No. _____

Address 12 Circle Road

Location _____

Kind of Pipe _____

Size _____

Size of Main _____

Repair—Renewal—New Service DeFelice Bros. #1155


Location _____

Date		Material	Amount		Total		Date		Amount	
8/12/68	10'	4" Cast Iron								
	58'	6" Transite Pipe								

DATE _____

TOWN OF LEXINGTON — BOARD OF PUBLIC WORKS
SEWER DIVISION

Sketch of Service Here **12**

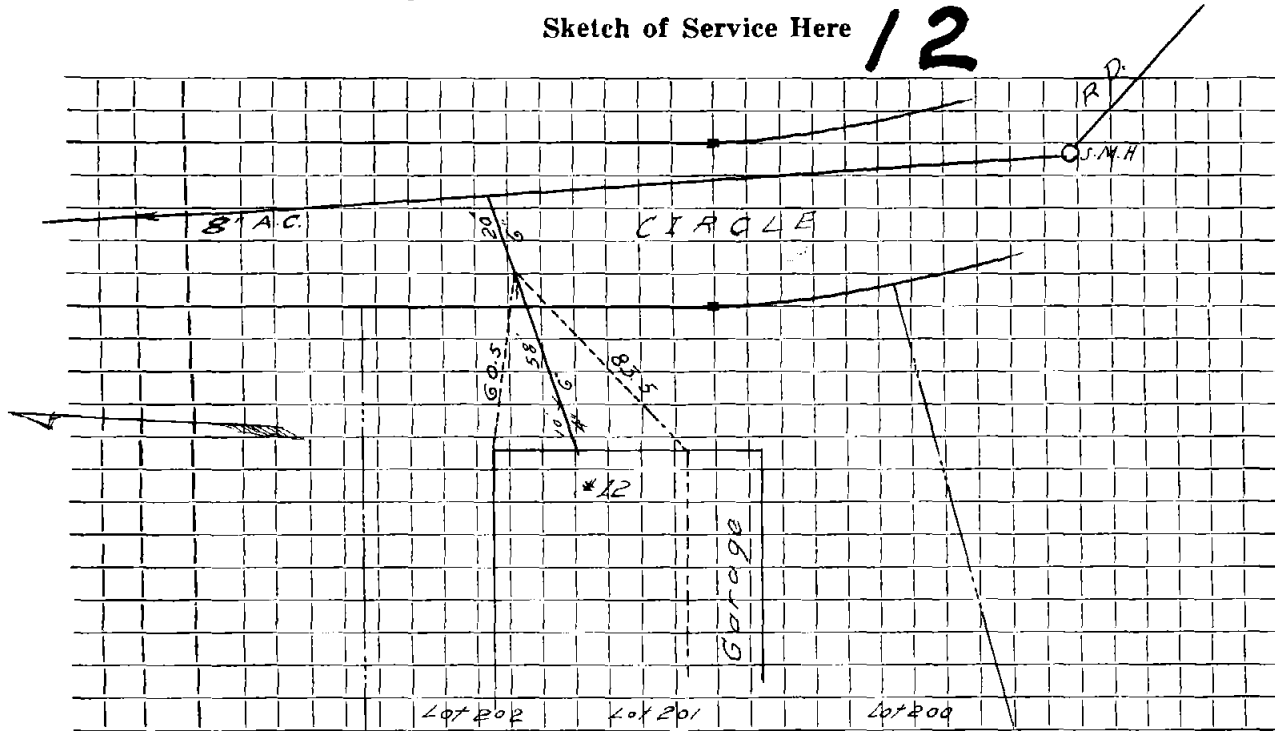

Connection made in Street. Work completed

Remarks:
.....
.....