
Name Service No. Scott Properties Address 17 Circle Road Location Kind of Pipe Size of Main Size Repair-Renewal-New Service Location Total Date Material Amount Date Amount INSTALLED BY CONTRACTOR 1975 E.B.M.18501

DV.	TE			
$\sim$		 	 	 

## TOWN OF LEXINGTON - BOARD OF PUBLIC WORKS

## SEWER DIVISION

## Sketch of Service Here

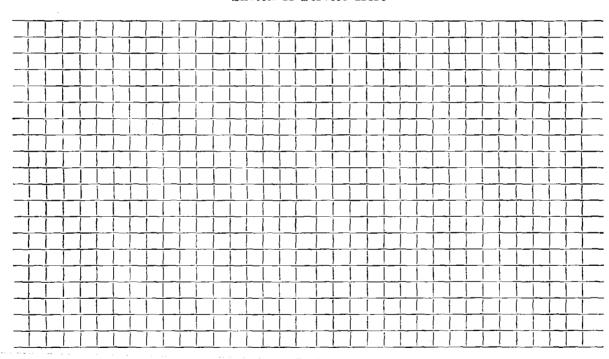

Connection made in	Street.	Work completed	
Remarks:			• • • • • • • • • • • • • • • • • • • •