

Name Theodore Setterlund

Service No.

Address 2 Circle Road

Location

Kind of Pipe

Size

Size of Main

Repair—Renewal—New Service DeFlice Bros. #909

Location

Date	Material	Amount	Total	Date	Amount
------	----------	--------	-------	------	--------

12-6-67	29' Transite pipe				
---------	-------------------	--	--	--	--


	10' 4" Transite pipe				
--	----------------------	--	--	--	--

DATE _____

TOWN OF LEXINGTON — BOARD OF PUBLIC WORKS

SEWER DIVISION

Sketch of Service Here **2**

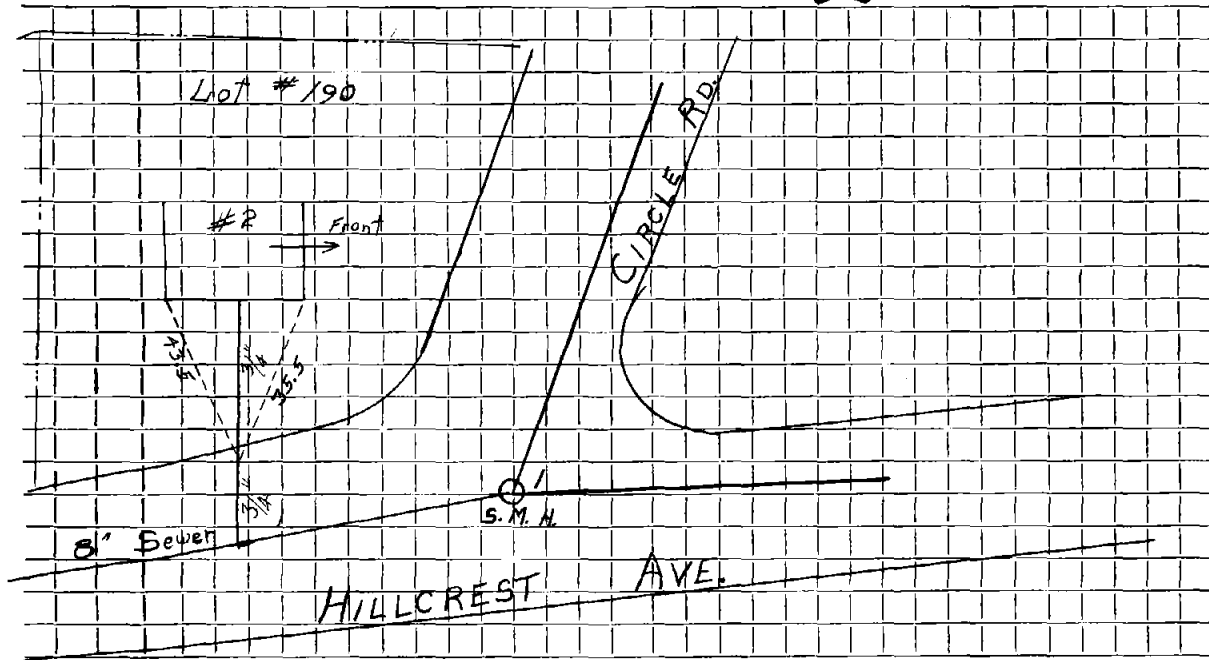

Connection made in Street. Work completed

Remarks:
.....
.....