
Name Service No. Scott Properties Address 21 Circle Road Location Kind of Pipe Size of Main Size Repair-Renewal-New Service Location Material Date **Amount** Total Date **Amount** INSTALLED BY CONTRACTOR 1975 H.B.M.18501

DAT	F	 	

## TOWN OF LEXINGTON - BOARD OF PUBLIC WORKS

## SEWER DIVISION

## Sketch of Service Here

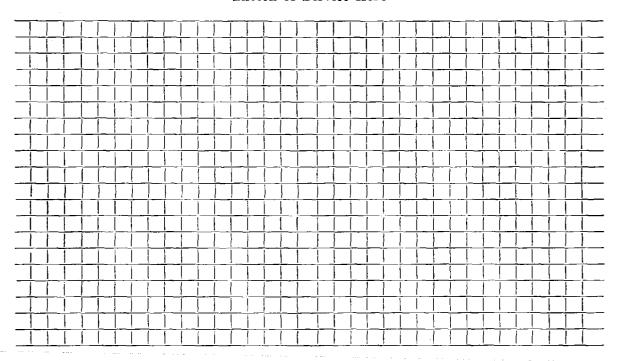

Connection made in Street.	Work completed
Remarks:	