

Name Busa Reality Trust

Service No.

Address 24 Circle Road

lot # 206-208

Location

Kind of Pipe

Size

Size of Main

Repair—Renewal—New Service

DeFlice # 1014


Location

Date	Material	Amount		Total	Date	Amount	
1968	29' 6" Transite Pipe						
	10' 4" Cast Iron						

DATE _____

TOWN OF LEXINGTON — BOARD OF PUBLIC WORKS
SEWER DIVISION

Sketch of Service Here **24**

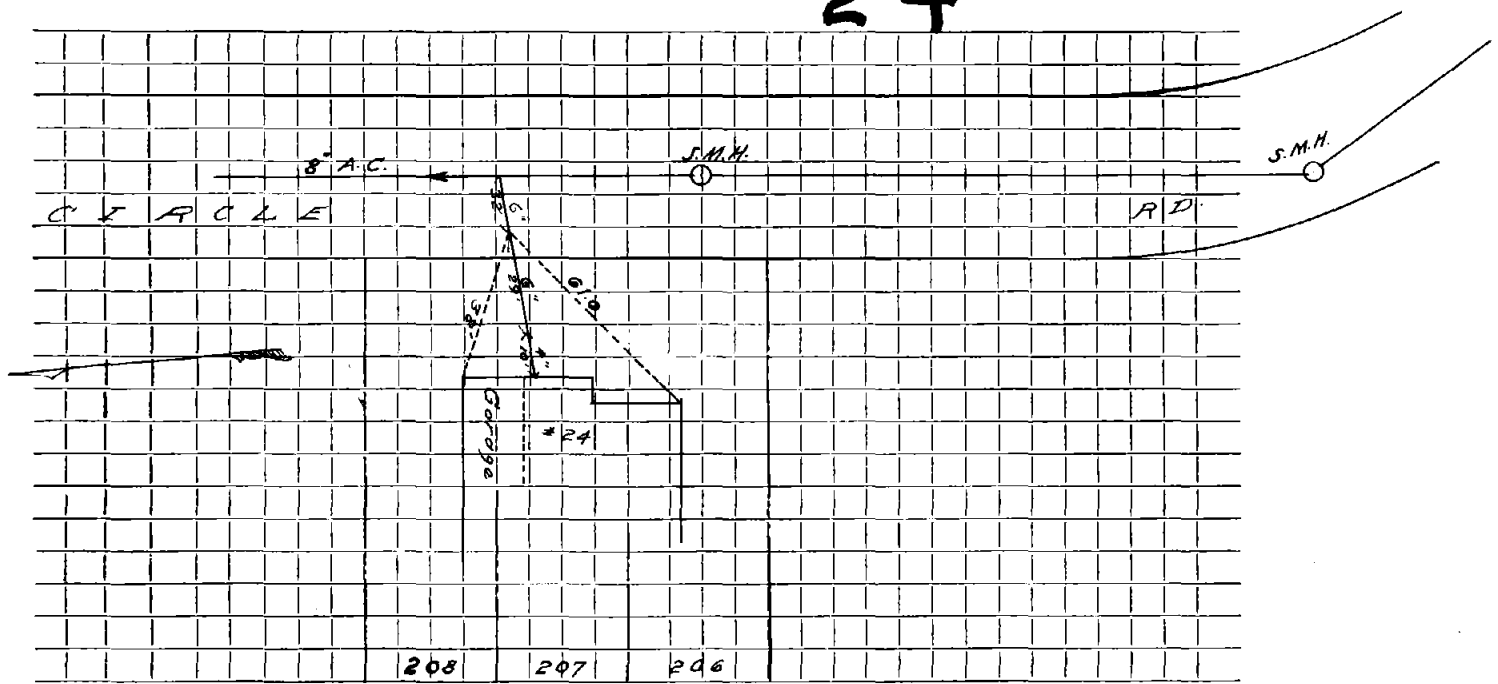

Connection made in Street. Work completed

Remarks:
.....
.....