

Name I. W. Stephens

Service No.

Address 31 Circle Road

Location

Kind of Pipe

Size

Size of Main

Repair—Renewal—New Service Lucente #725


Location

| Date   |     | Material         | Amount |  | Total |  | Date |  | Amount |  |
|--------|-----|------------------|--------|--|-------|--|------|--|--------|--|
| 8-8-67 | 46' | 6" Transite pipe |        |  |       |  |      |  |        |  |
|        | 10' | 4" Cast Iron     |        |  |       |  |      |  |        |  |
|        |     |                  |        |  |       |  |      |  |        |  |
|        |     |                  |        |  |       |  |      |  |        |  |
DATE \_\_\_\_\_

TOWN OF LEXINGTON — BOARD OF PUBLIC WORKS  
SEWER DIVISION

Sketch of Service Here **31**

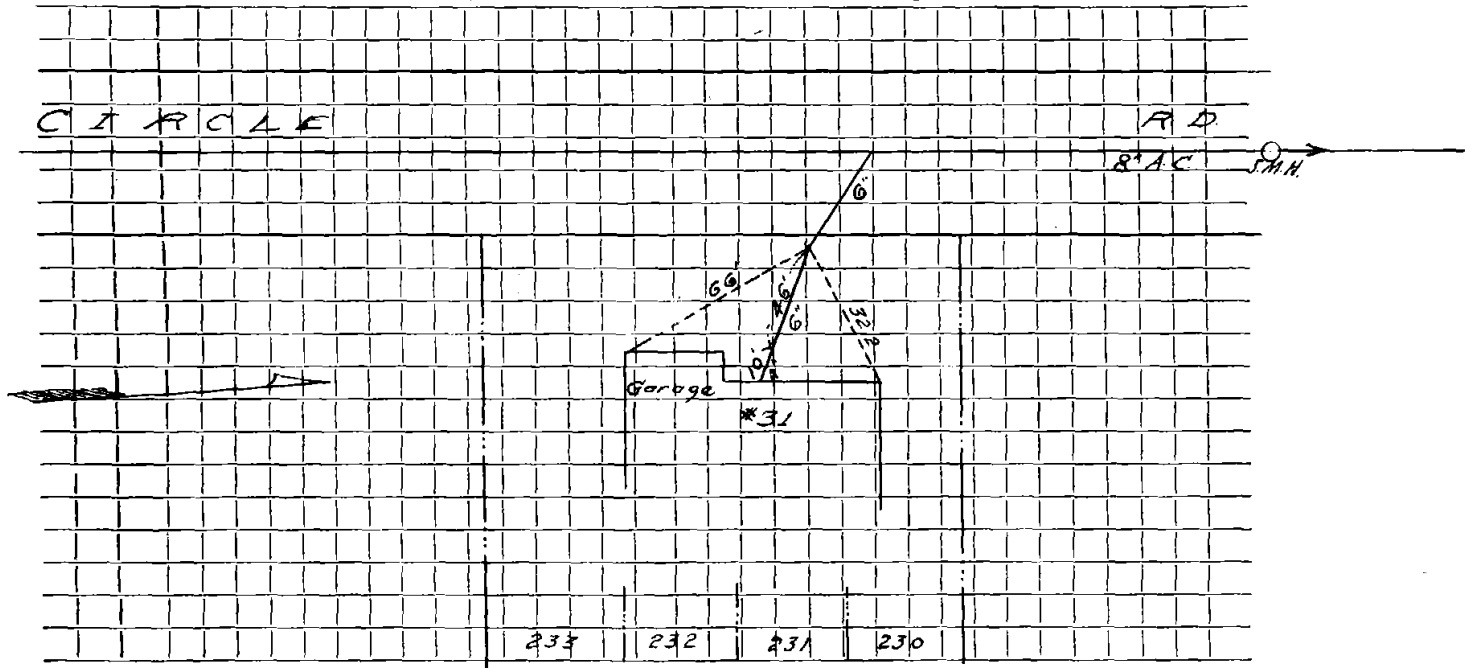

Connection made in ..... Street. Work completed .....

Remarks: .....  
.....  
.....