

Name A.J. Maillett Corporation

Service No.

Address 39 Circle Road

Location

Kind of Pipe

Size

Size of Main

~~Repair/ Renewal~~ — New Service Sibley #3298

Location

Date

Material

Amount

Total

Date

Amount

6/17/77

26'

6" Transite Pipe


10'

4" Cast Iron

DATE _____

TOWN OF LEXINGTON — BOARD OF PUBLIC WORKS
SEWER DIVISION

Sketch of Service Here **39**

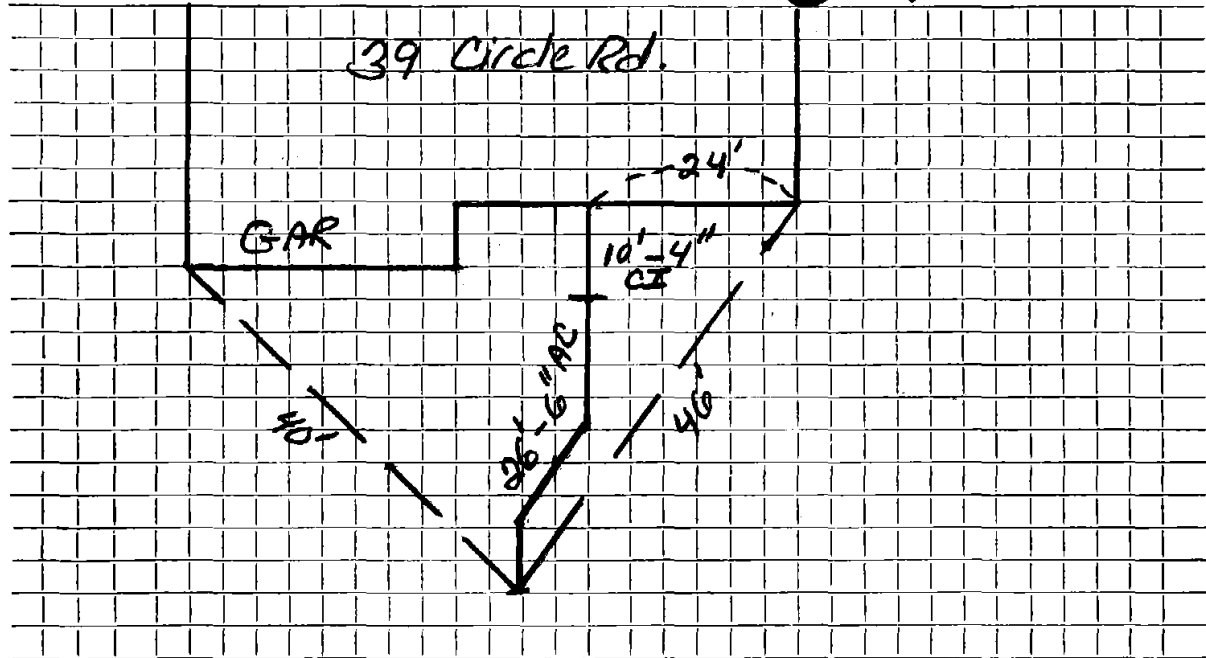

Connection made in Street. Work completed

Remarks:
.....
.....