

Name David Malex

Service No.

Address 42 Circle Road

Location

Kind of Pipe

Size

Size of Main

~~Repair~~ ~~Renewal~~ New Service Valeri #3554

Location

Date		Material	Amount		Total		Date		Amount	
------	--	----------	--------	--	-------	--	------	--	--------	--


11-26-80	50'	P.V.C. pipe								
	10'	Cast iron pipe								

DATE \_\_\_\_\_

TOWN OF LEXINGTON — BOARD OF PUBLIC WORKS  
SEWER DIVISION

Sketch of Service Here

42

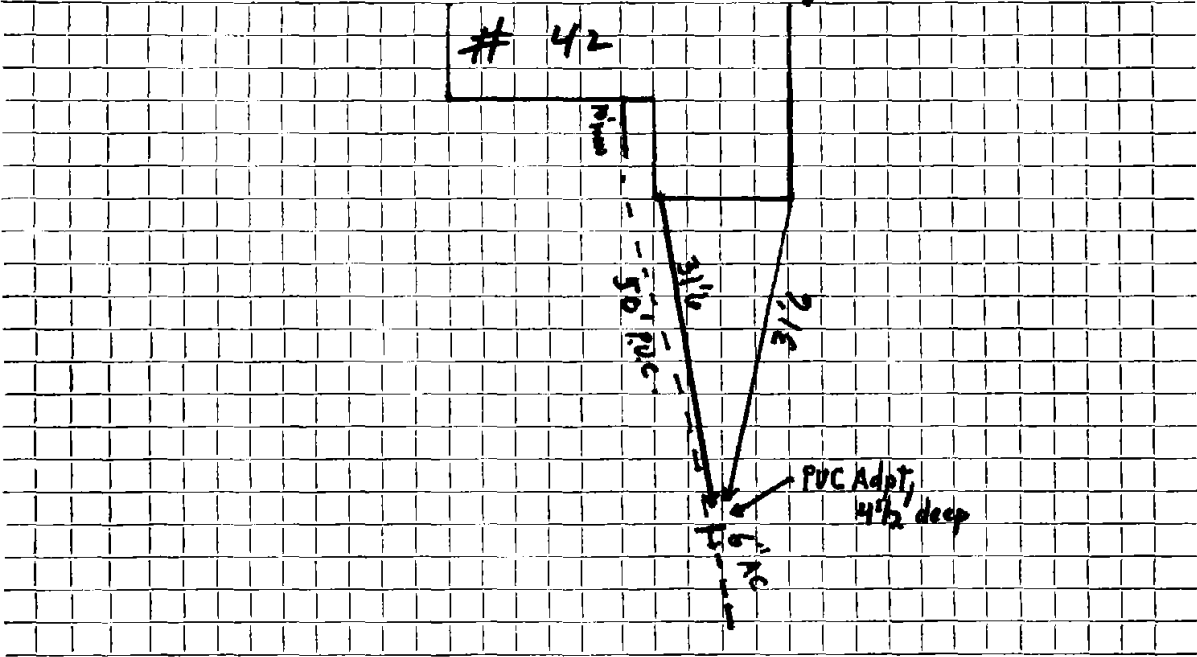

Connection made in Circle rd ..... Street.      Work completed .....

Remarks: .....  
.....  
.....