

Name Antonio Busa

Service No.

Address 43 Circle Road

J.M. Lucente Co. - Permit #A139

Location Lot #7

Kind of Pipe

Size

Size of Main

Repair—Renewal—New Service

Location

Date

Material

Amount

Total

Date

Amount


6/30/66 52'

6" Transite

DATE \_\_\_\_\_

**TOWN OF LEXINGTON — BOARD OF PUBLIC WORKS**  
**SEWER DIVISION**

Sketch of Service Here **43**

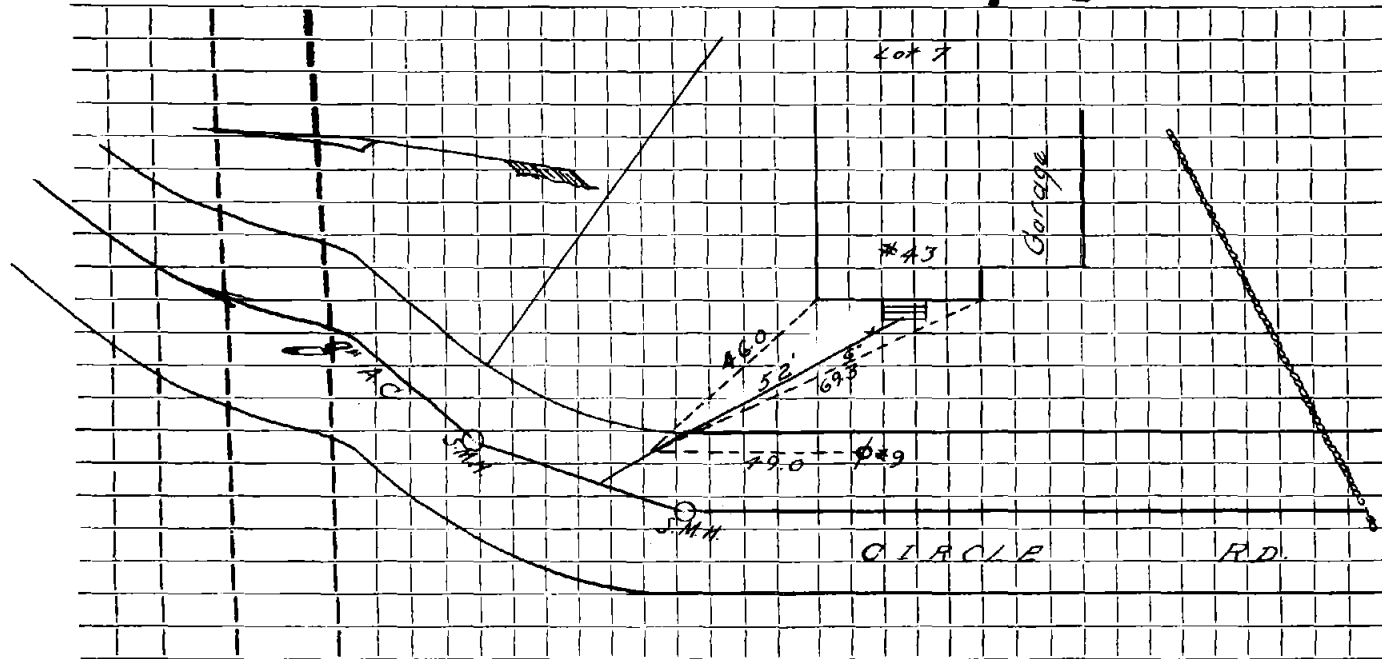

Connection made in ..... Street. Work completed .....

marks: .....

.....  
.....

