

Name Busa Realty Trust

Service No.

Address 44 Circle Road

Location Lot #5

Kind of Pipe

Size

Size of Main

Repair—Renewal—New Service

DeFlice Bros. - Permit #654

Location

Date	Material	Amount	Total	Date	Amount
6/14/67	35' 6" Transite				
	10' 4" Cast Iron				


H.R.M.18501

DATE _____

TOWN OF LEXINGTON — BOARD OF PUBLIC WORKS
SEWER DIVISION

Sketch of Service Here

44

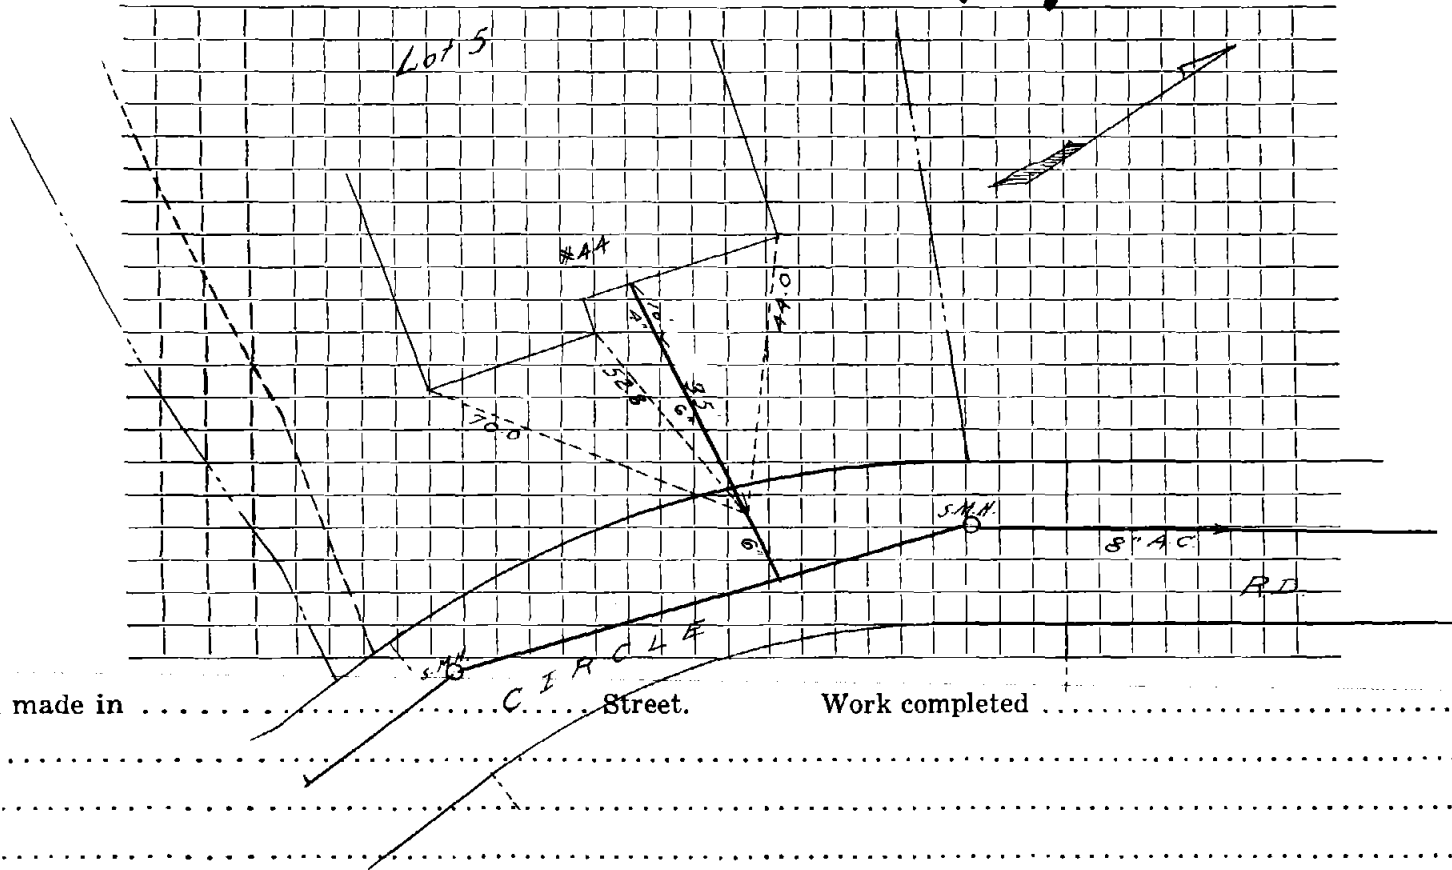

Connection made in Street. Work completed

Remarks:

.....

.....