

Name Antonio Busa

Service No.

Address 46 Circle Road

Lot #4

Location

Kind of Pipe

Size

Size of Main

Repair—Renewal—New Service DeFlice Bros. #503

Location


| Date    |     | Material          | Amount |  | Total |  | Date |  | Amount |  |
|---------|-----|-------------------|--------|--|-------|--|------|--|--------|--|
| 12/8/68 | 33' | 6" Transite pipe  |        |  |       |  |      |  |        |  |
|         | 10' | 4" Cast Iron Pipe |        |  |       |  |      |  |        |  |
|         |     |                   |        |  |       |  |      |  |        |  |
|         |     |                   |        |  |       |  |      |  |        |  |
DATE \_\_\_\_\_

TOWN OF LEXINGTON — BOARD OF PUBLIC WORKS  
SEWER DIVISION

Sketch of Service Here

**46**

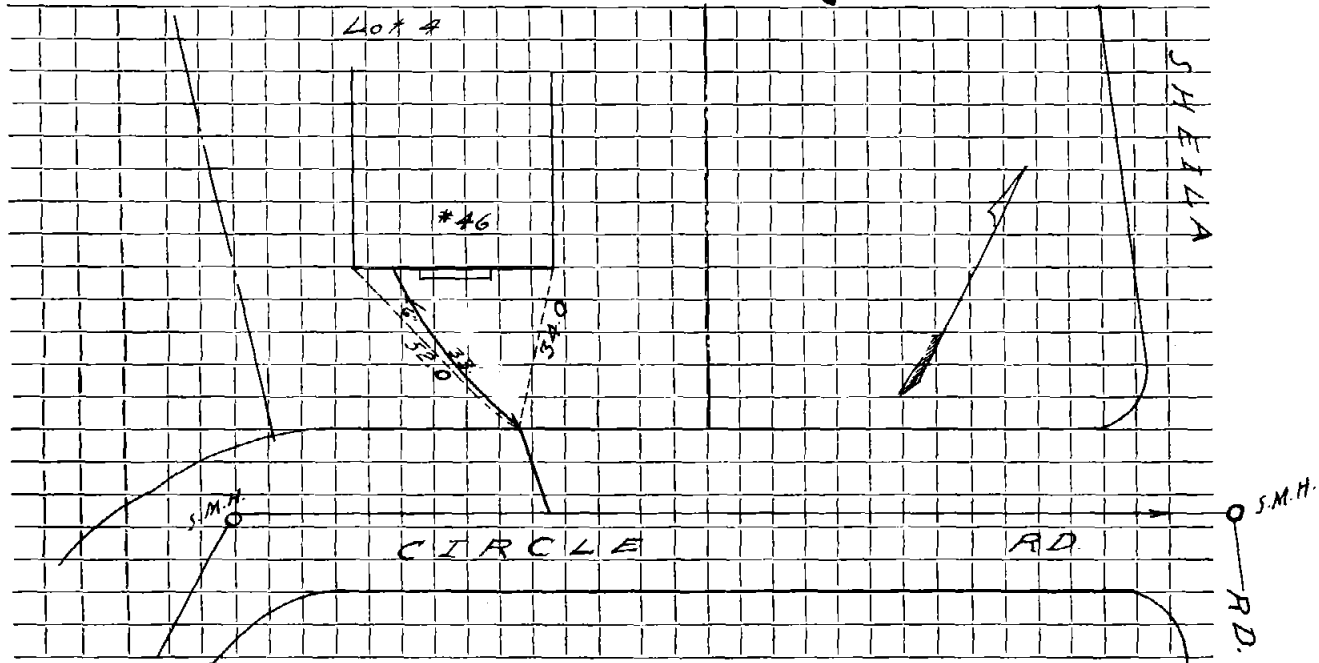

Connection made in ..... Street. Work completed .....

Remarks: .....

.....

.....